


T. 4 S. R. 10 W. W. M.

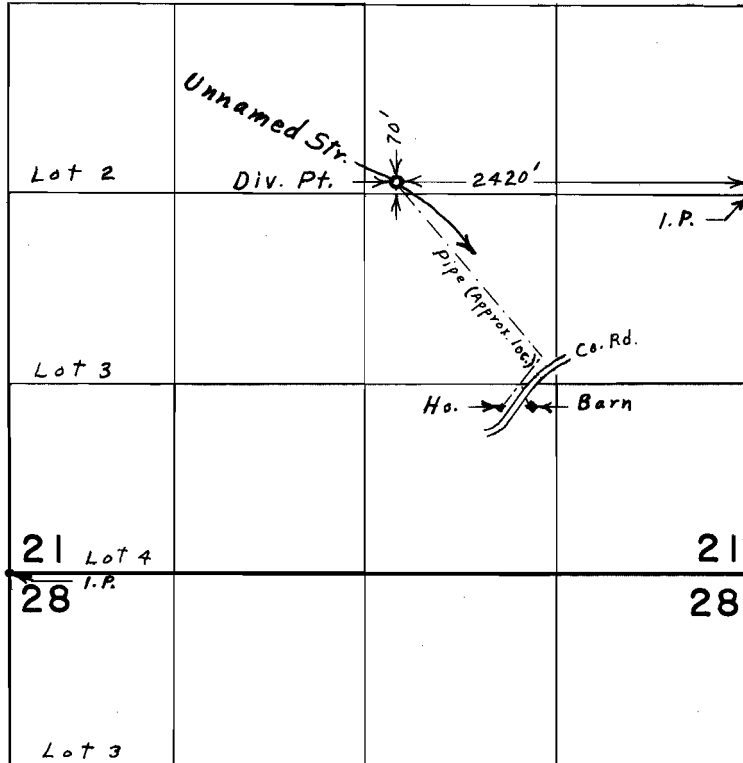

FINAL PROOF SURVEY UNDER

Application No. 44451 Permit No. 33247
IN NAME OF

EVERETT & DOROTHY GIST

June 26, 1974 L. M. Toll
Surveyed Aug. 10, 1971, by L. E. Gould