G-4275
42267

T. 2 N. R. 33 E. W.M.

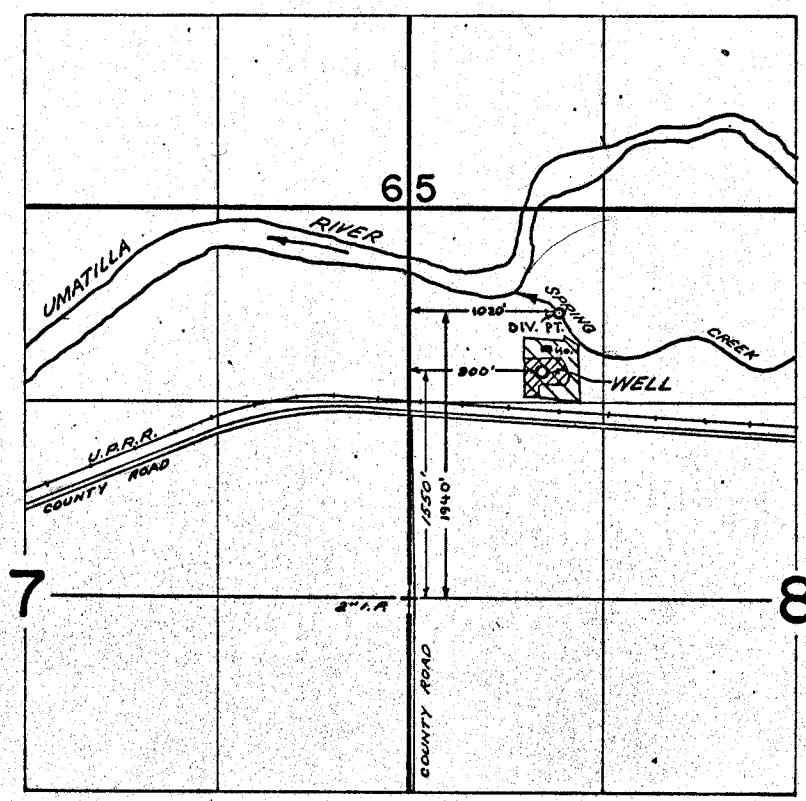

▨ - PRIMARY FROM SPRING CREEK - 3⅝ A.

▨ - SECONDARY FROM WELL - 1¼ A.

FINAL PROOF SURVEY
UNDER

45270 33808
Application No. G-4546 Permit No. G-4275
IN NAME OF

HAROLD H. HART

Surveyed APR. 17 1973, by D. M. NORBY
JULY 30, 1974 L. TOLL

NZ-2MM-63 OAB