


G-4409
42768

T586N. R.35E. WM.

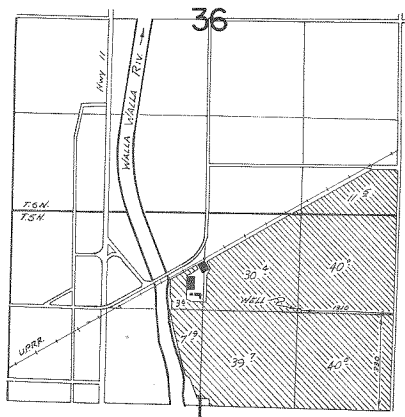

FINAL PROOF SURVEY
UNDER

Application No. G-4688 Permit No. G-4409
IN NAME OF

MILTON NURSERY COMPANY

Surveyed APRIL 12, 1979, by R.G. MCKEN