


G-4438
42269

T. 1 S., R. 32 E., W. M.

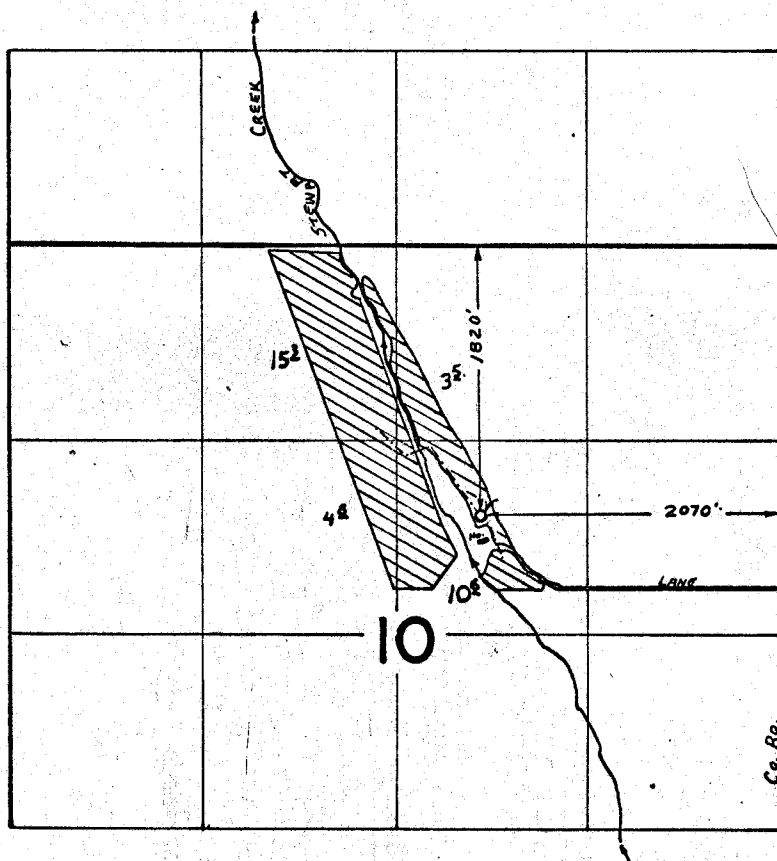

FINAL PROOF SURVEY UNDER

Application No. G-4714 Permit No. G-4438
IN NAME OF

JACK E. ETTER

Surveyed Aug. 6 1974, by L. TOLL