


42273

G-5034

T.4N., R.28E., W.M.

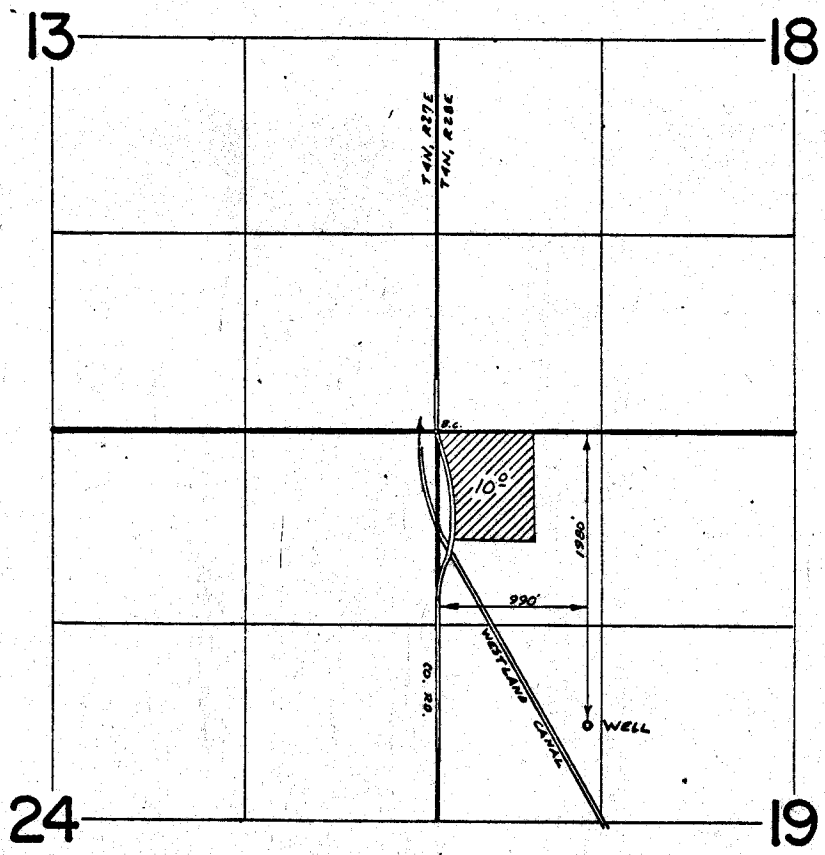

FINAL PROOF SURVEY UNDER

Application No. G-5734 Permit No. G-5034
IN NAME OF

MALCOLM SKINNER

Surveyed April 8 1974, by D. Norby