


G-5110
42274

T.4N., R.29E., W.M.

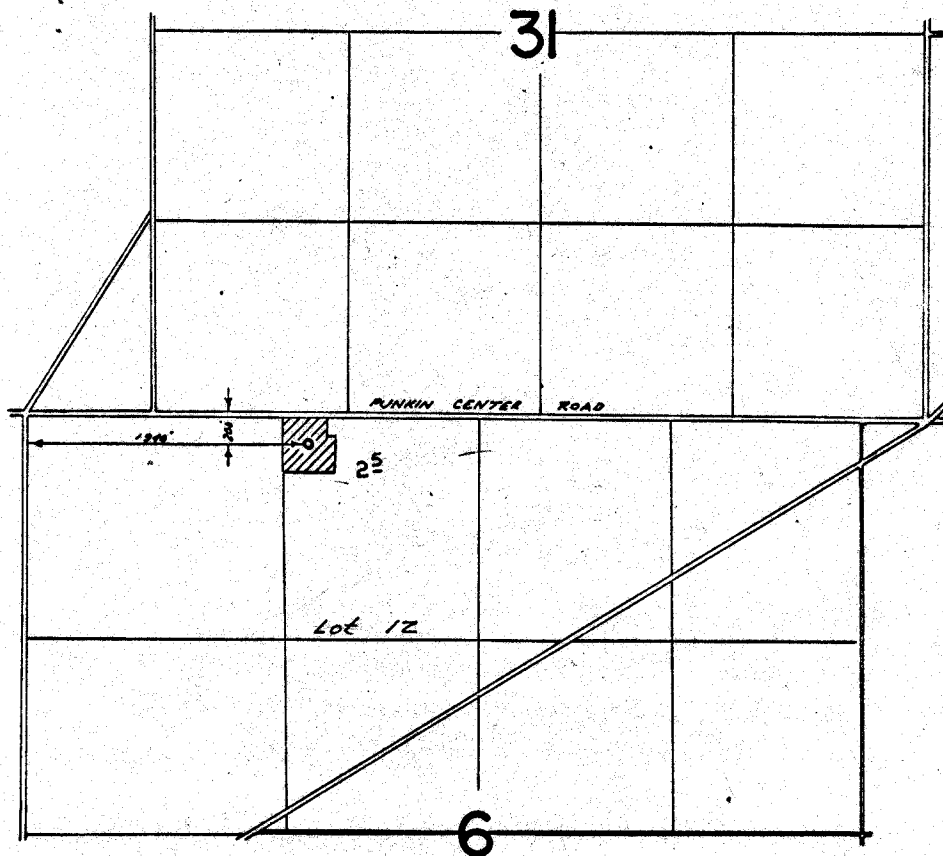

FINAL PROOF SURVEY
UNDER

Application No. G-5259 Permit No. G-5110
IN NAME OF

HAROLD O. COX

Surveyed April 9 1914 by David Torby