


T.2N.,R.33E.,W.M.

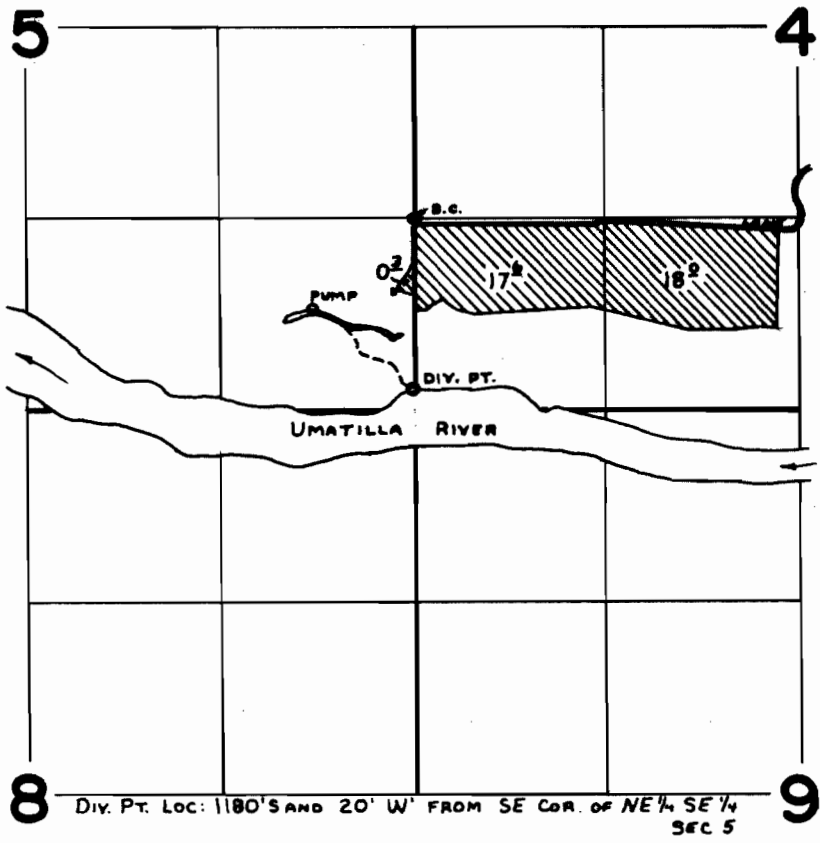

FINAL PROOF SURVEY
UNDER

Application No. 43070 Permit No. 31593
IN NAME OF

.....WILLIAM DUFF.....

Surveyed JULY 30 1974, by L. TOLL.....