copy

T. 2 N. R. 33 E. W.M.

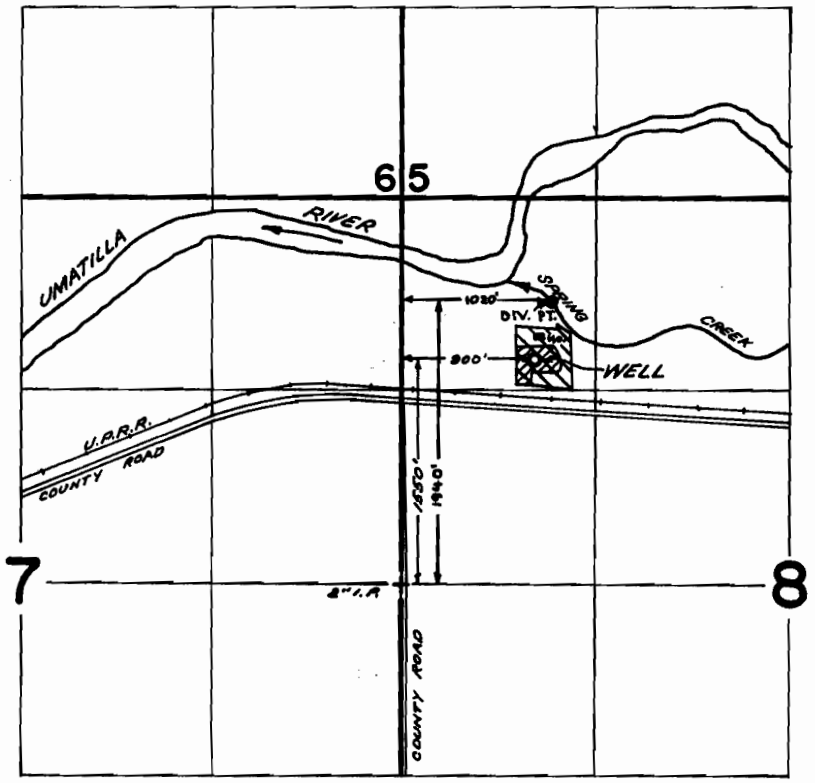

▨ - PRIMARY FROM SPRING CREEK - 3½ A.

▨ - SECONDARY FROM WELL - 1¼ A.

FINAL PROOF SURVEY
UNDER

Application No. 45270 G-4546 Permit No. 33808 G-4275

IN NAME OF

HAROLD H. HART

Surveyed APR. 17 1973, by D. M. NORBY
JULY 30, 1974 L. TOLL

NZ-RMM-63 DAB