


T.2N.R.11&12E.W.M.

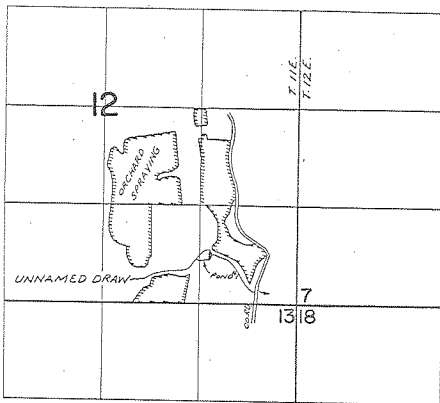

DIV. PT. LOC: 650' N. & 1180' W. FROM S.E. COR. SEC. 12

FINAL PROOF SURVEY UNDER

R-43417 R-4983
 Application No. 43672 Permit No. 32430
 IN NAME OF

Kenneth E. & Joan M. Hudson

Surveyed APR. 22, 1974, by D. NORBY.