


T.3S., R.4W., W.M.

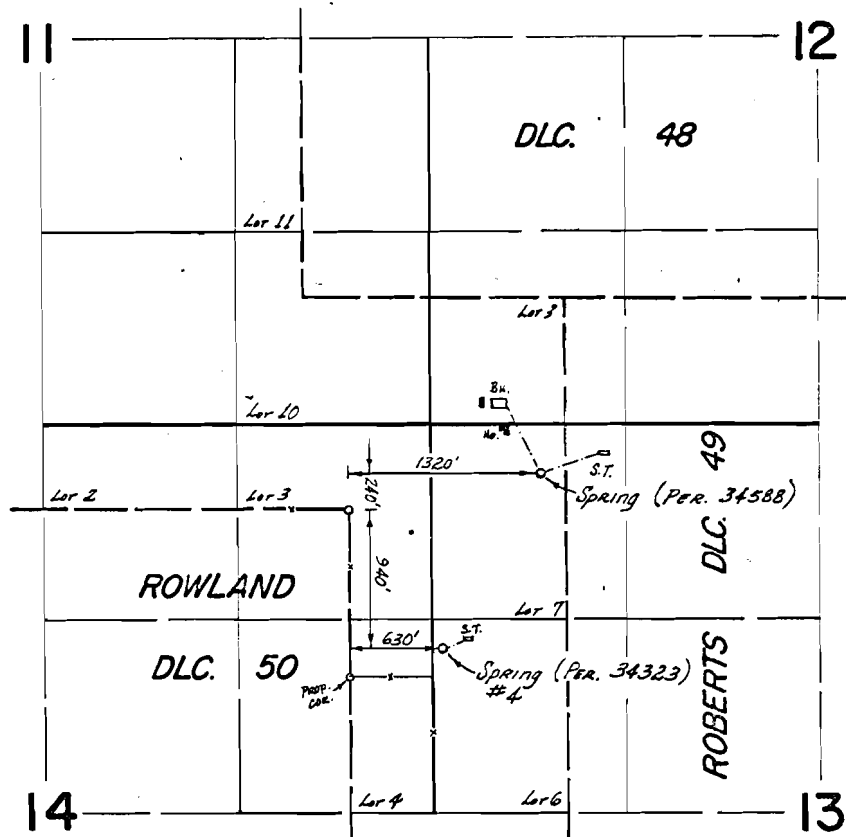

FINAL PROOF SURVEY
UNDER

45948 34323
Application No. 46310 Permit No. 34588
IN NAME OF

ERVIN E. BRISCOE

Surveyed SEPT. 18, 1973, by L. E. GOULD