T.3S., R.4W., W.M.

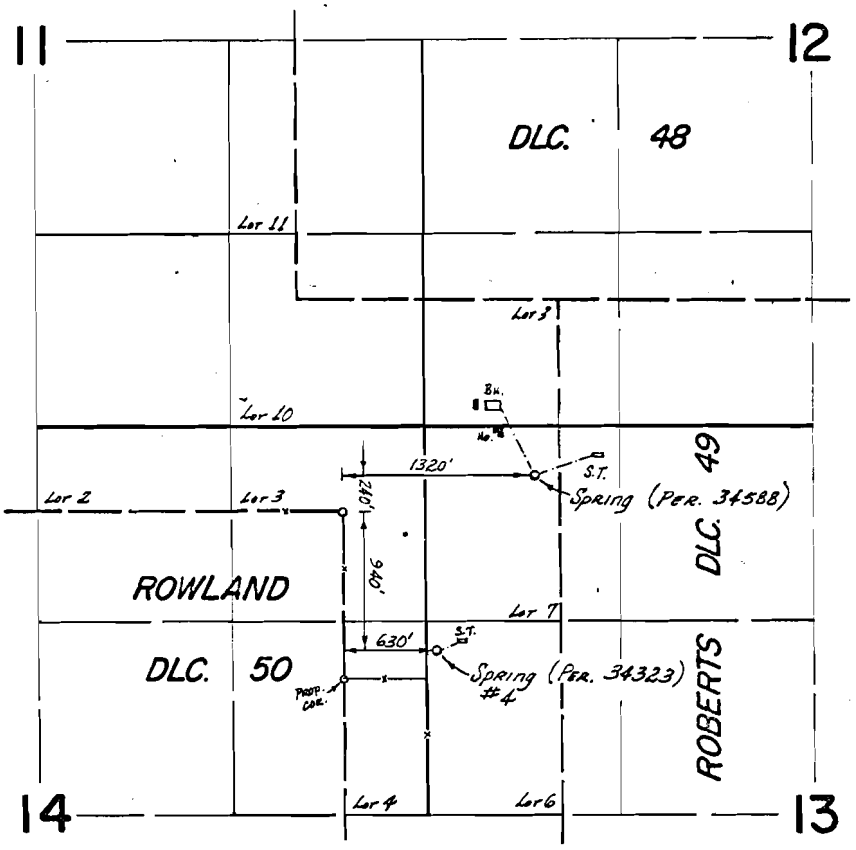

FINAL PROOF SURVEY

UNDER

Application No. 45948 46310 Permit No. 34323 34588

IN NAME OF

ERVIN E. BRISCOE

Surveyed Sept. 18 19 73, by L. E. Gould

1973-T