


# T. 4 S. R. 3 W. W.M.

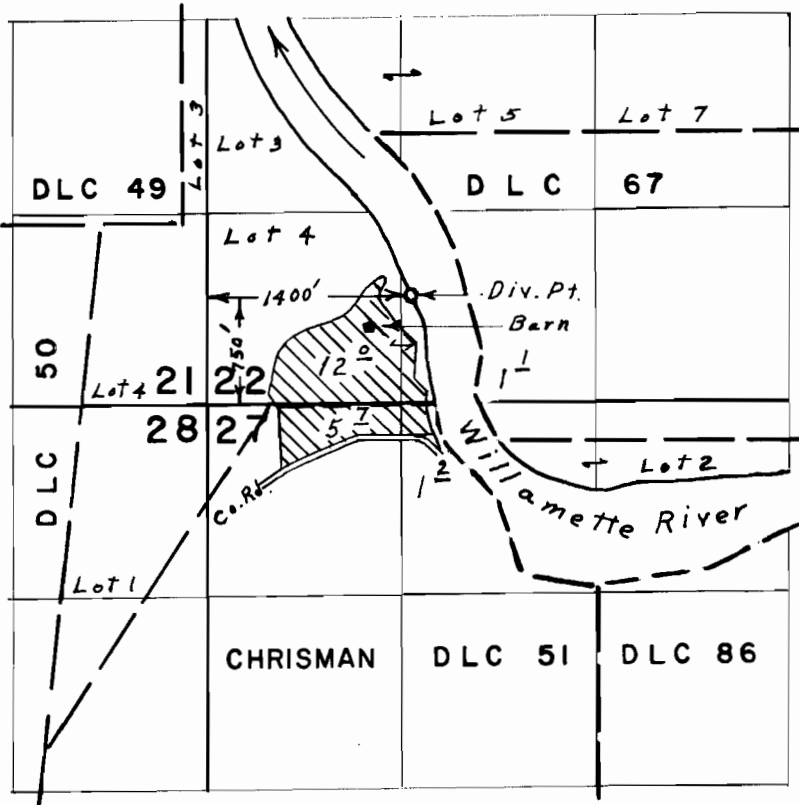

## FINAL PROOF SURVEY UNDER

Application No. 46540... Permit No. 34770  
IN NAME OF

**ROBERT P. CRAIG**

Surveyed March 15, 1973, by L. E. Gould