


T.14S., R.5W., W.M.

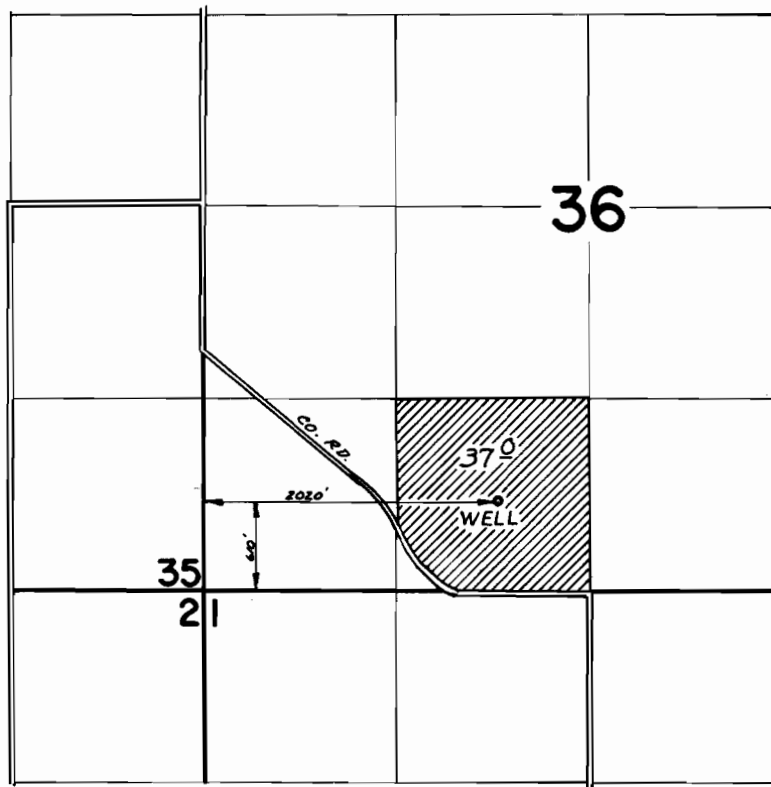

FINAL PROOF SURVEY
UNDER

Application No. G-4061 Permit No. G-3807
IN NAME OF

ROBERT GORACKE

Surveyed APRIL 5 1973, by D. NORBY