


T.14S., R.8W., W.M.

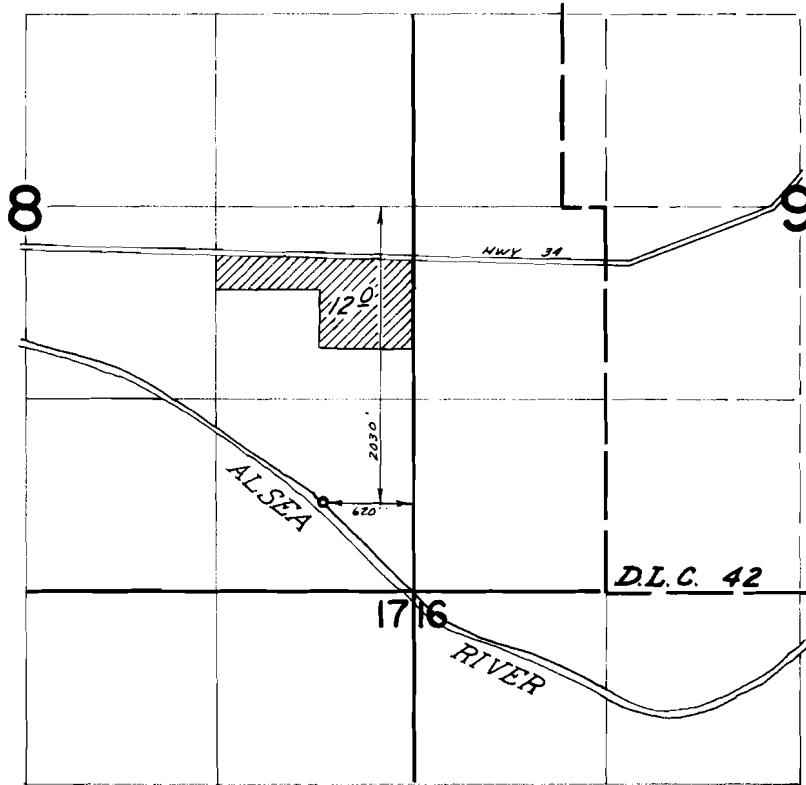

FINAL PROOF SURVEY
UNDER

Application No. 45945 Permit No. 34322
IN NAME OF

WILBUR W. MALTBY

Surveyed April 27 1973, by D.M. NORBY