


T.3 S.R.1 W.W.M.

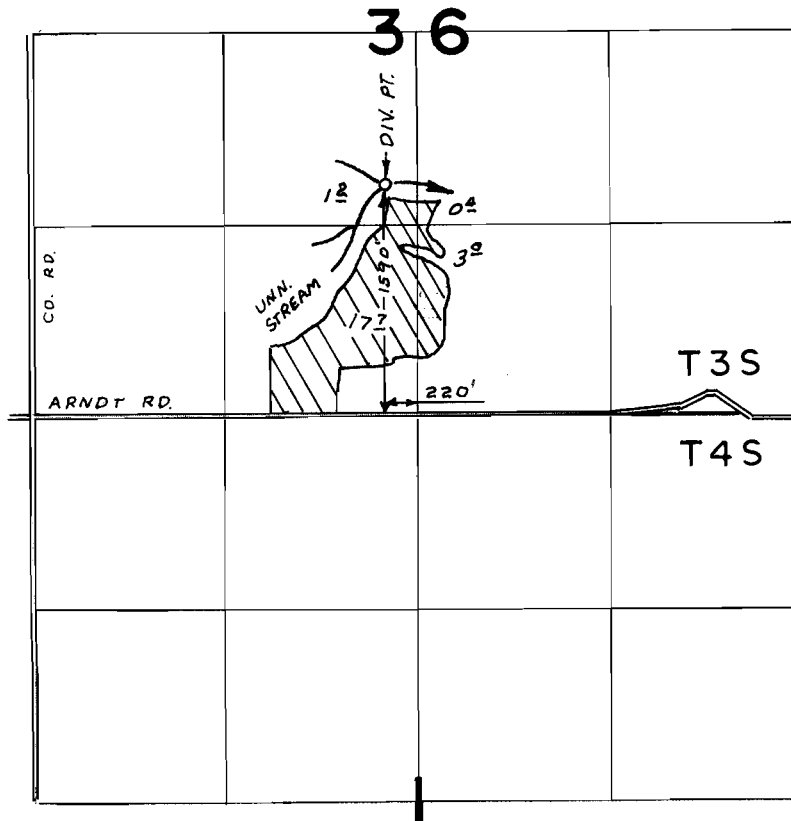

FINAL PROOF SURVEY
UNDER

Application No. 40370 Permit No. 30098
IN NAME OF

Robert I. Colvin

Surveyed NOV 8 1974, by L H NUNN