


T.13S. R.19E. W.M.

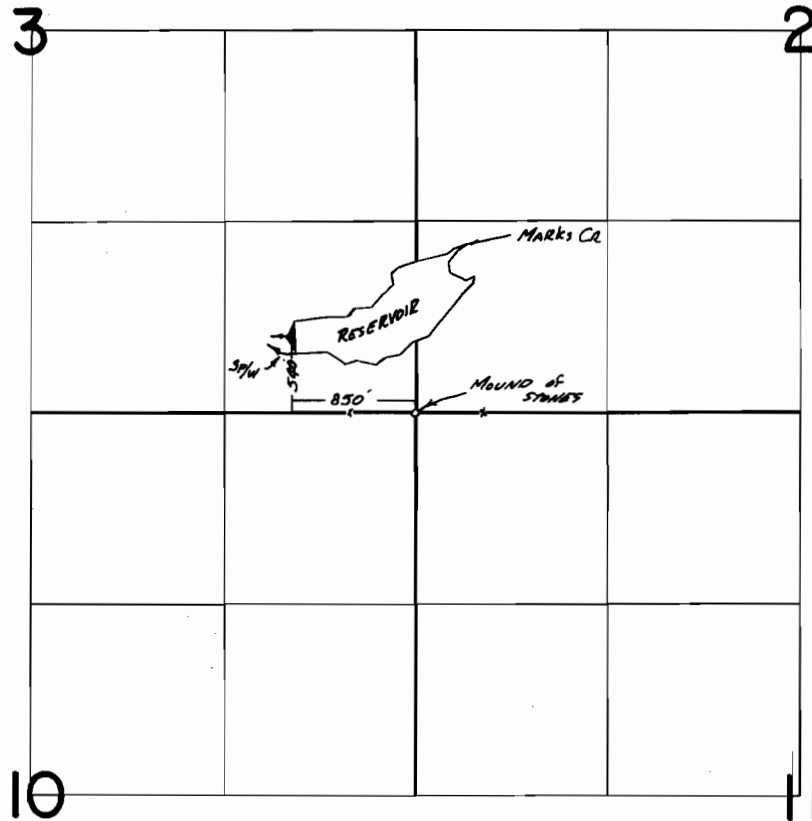

FINAL PROOF SURVEY
UNDER

R-40508 R-4575
Application No. 40727 Permit No. 30431
IN NAME OF

LEE RHODEN

Surveyed JULY 10 1974, by D. M. NORBY