


T.13S. R.19E. W.M.

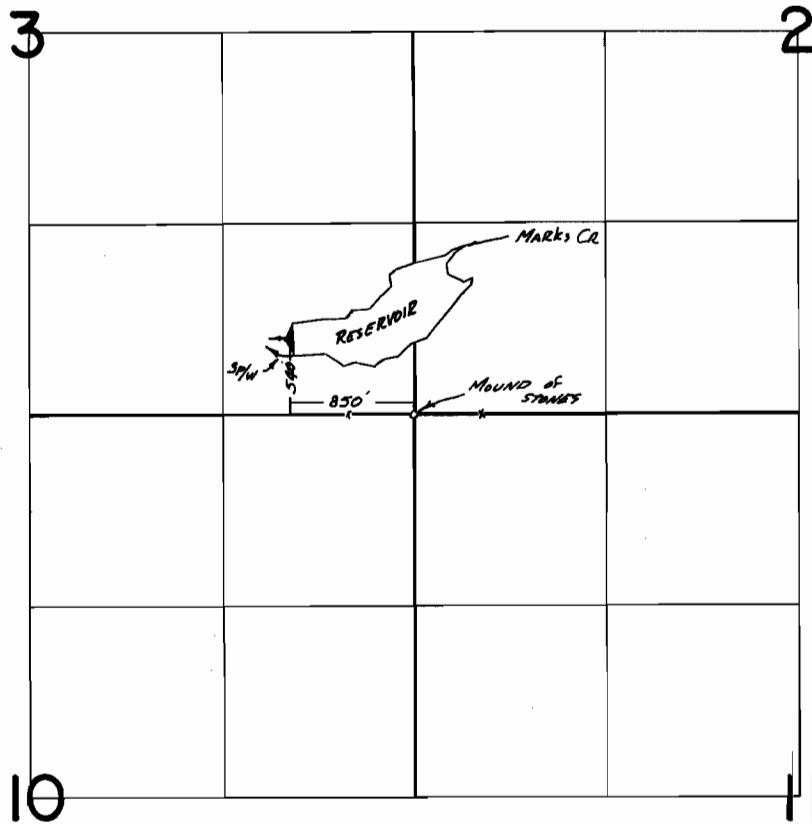

FINAL PROOF SURVEY
UNDER

R-40508 R-4575
Application No. ...40727. Permit No. ...30431..
IN NAME OF

..... LEE RHODEN

Surveyed JULY 10 1974, by D. M. NORBY.....