


T.37S. R.14W. W.M.

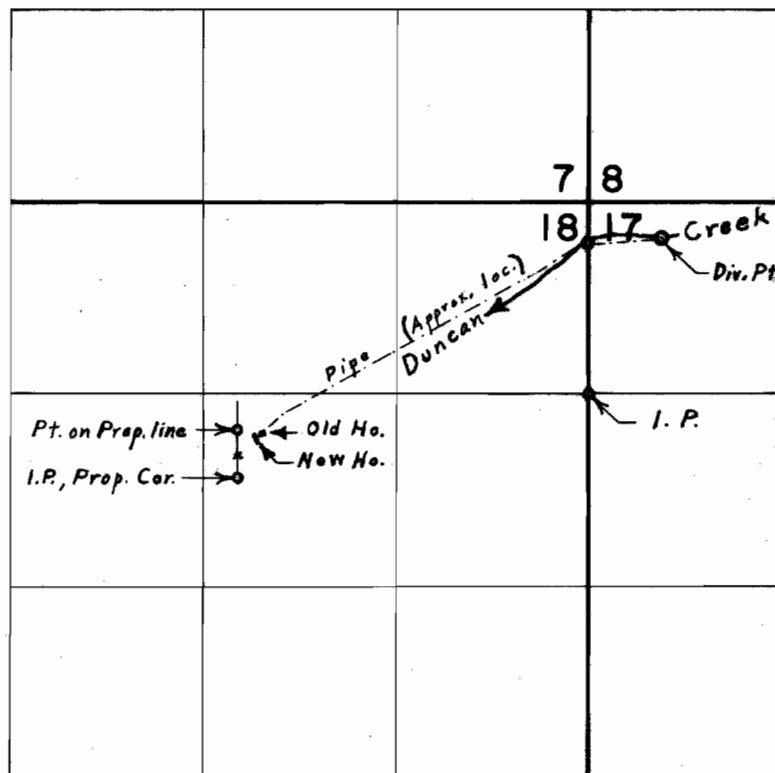

Div. Pt. located 1070' N. & 510' E. from S.E. Cor. N.E. $\frac{1}{4}$ N.E. $\frac{1}{4}$ Sec. 18

FINAL PROOF SURVEY
UNDER

Application No. 47602 Permit No. 35631
IN NAME OF

MRS. COLISTA M. DONALD

Surveyed Aug. 28, 1974, by L. E. Gould