


# T. 2 S. R. 22 E. W.M.

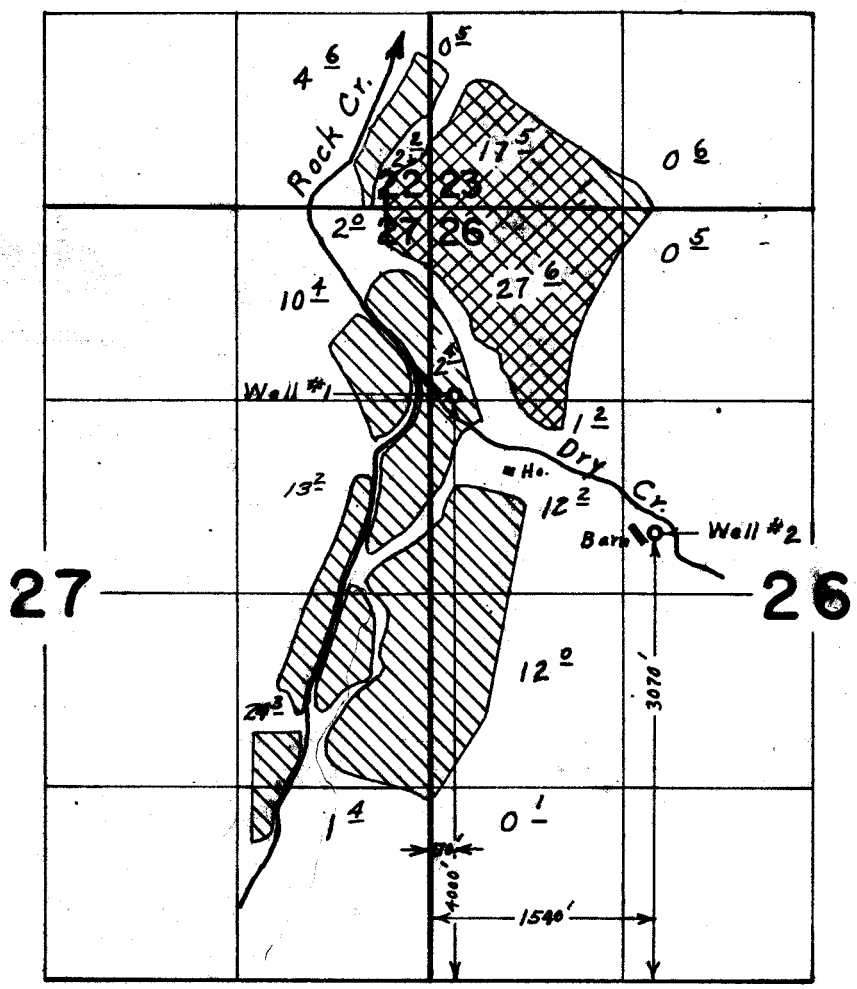

## FINAL PROOF SURVEY UNDER

Application No. G-3617 Permit No. G-3400  
G-4022 G-3780

IN NAME OF

**DALE BEAMER**

Surveyed *April 4, 1974*, by L. E. Gould

