



T. 2 S. R. 22 E. W. M.

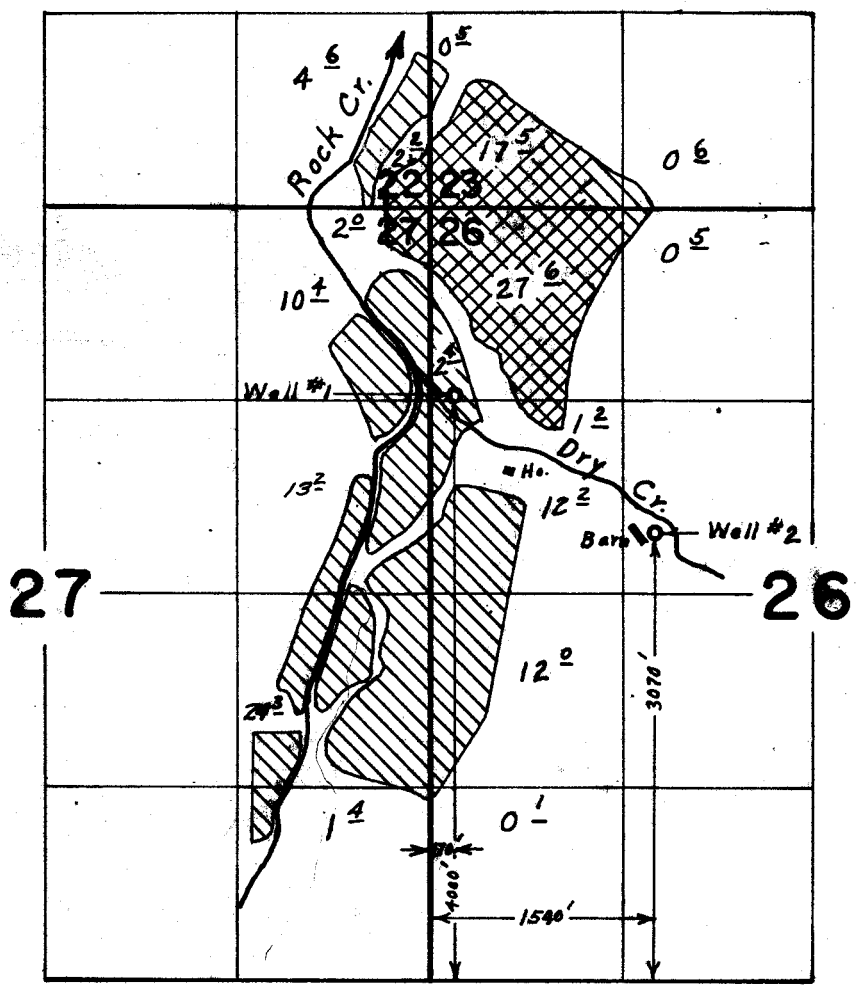

FINAL PROOF SURVEY UNDER

Application No. G-3617 Permit No. G-3400
G-4229 G-3780

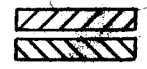

IN NAME OF
DALE BEAMER

Surveyed *April 4, 1974*, by *L. E. Gould*