


G-3876  
42296

# T.2&3 N. R.22&23 E. W.M.

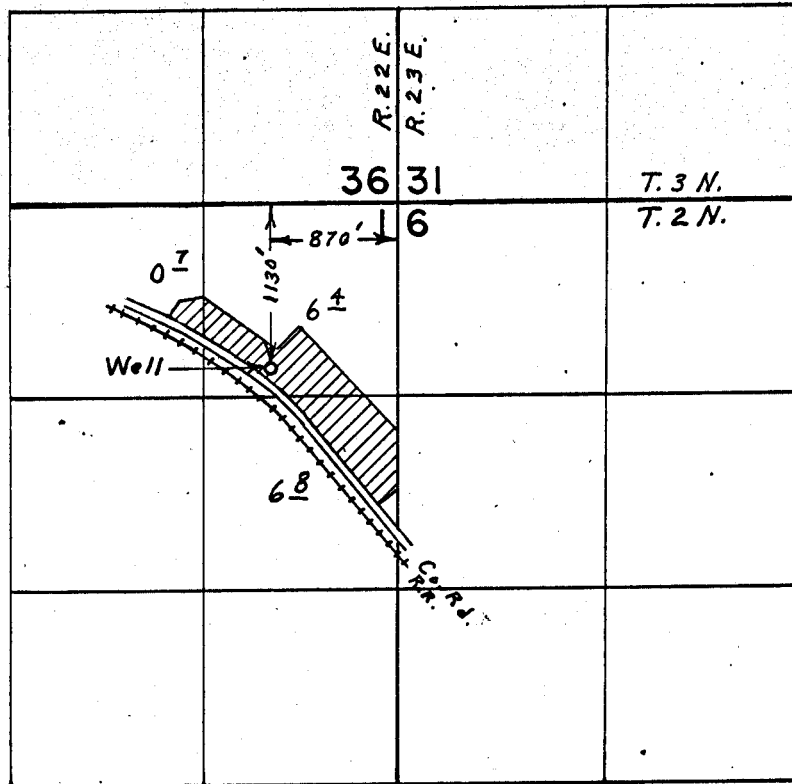

## FINAL PROOF SURVEY UNDER

Application No. G-4119 Permit No. G-3876  
IN NAME OF

GROVER C. & LUCY E. CURTISS

Surveyed April 11, 1974, by L. E. Gould