


T. 2 S. R. 22 E. W.M.

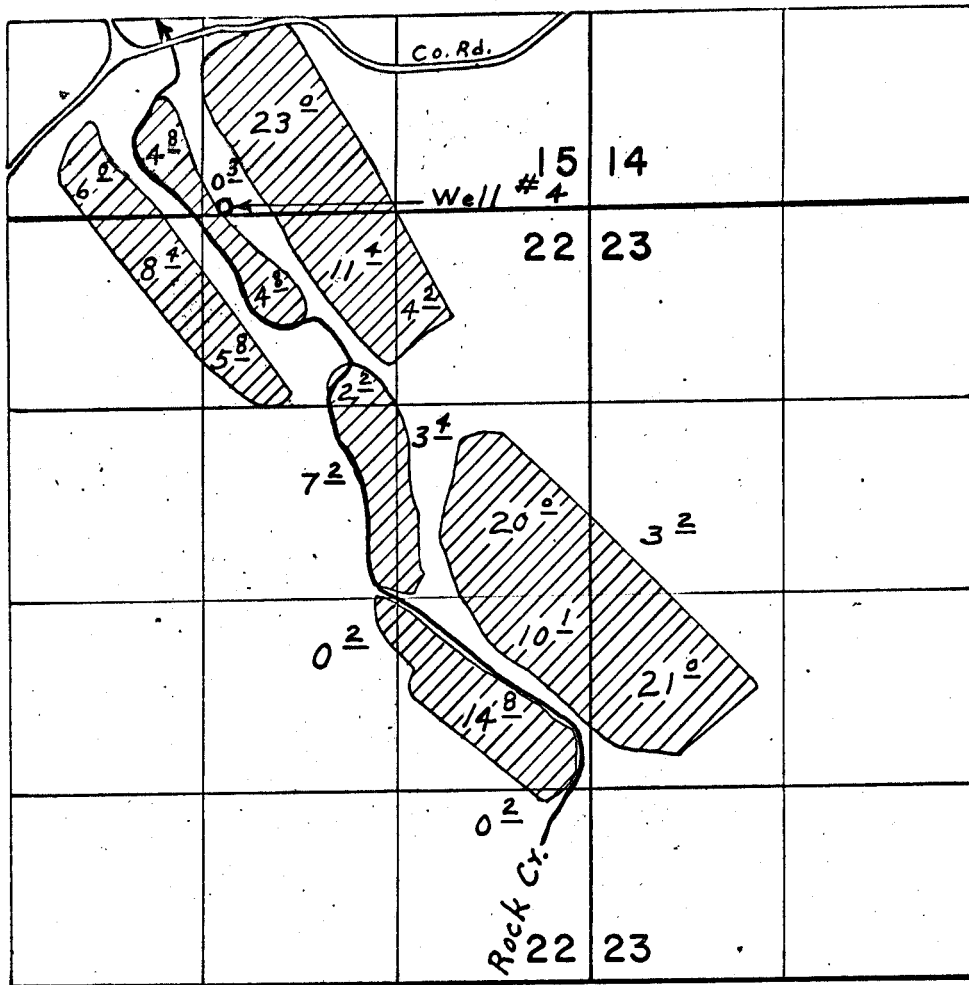

Well located 50' N. & 2480' W. from S.E. Cor. Sec. 15

FINAL PROOF SURVEY UNDER

Application No. G-4185 Permit No. G-3952
IN NAME OF

DALE BEAMER

Surveyed April 4, 1974, by L. E. Gould