


T.5S. R.21E. W.M.

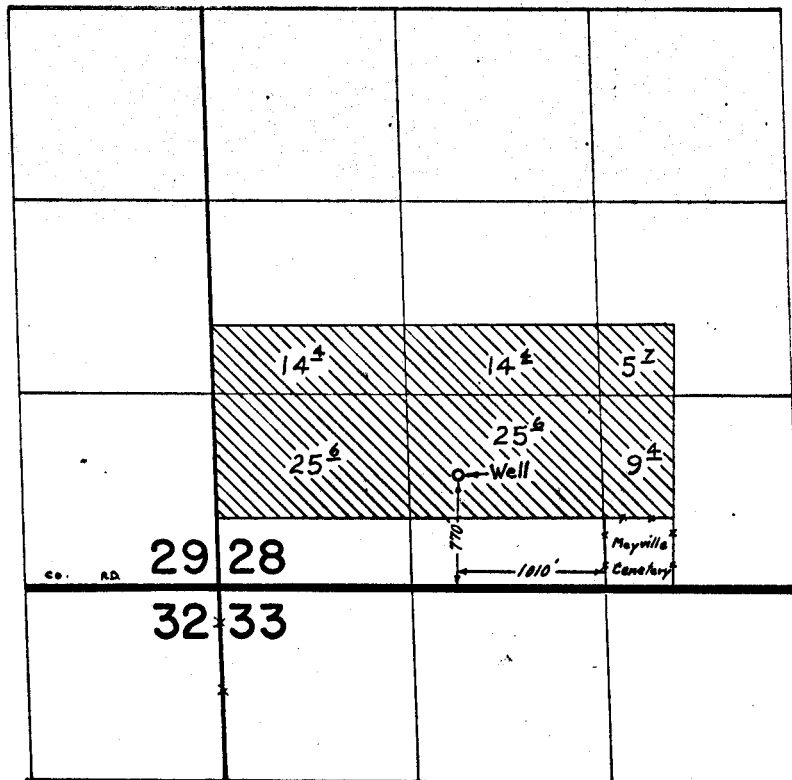

FINAL PROOF SURVEY
UNDER

Application No. G-5120 Permit No. G-4858
IN NAME OF

CHESTER R. & ROBERTA DYER

Surveyed APRIL 3, 1974 by L.E. GOULD