


T.39S.,R.5W.,W.M.

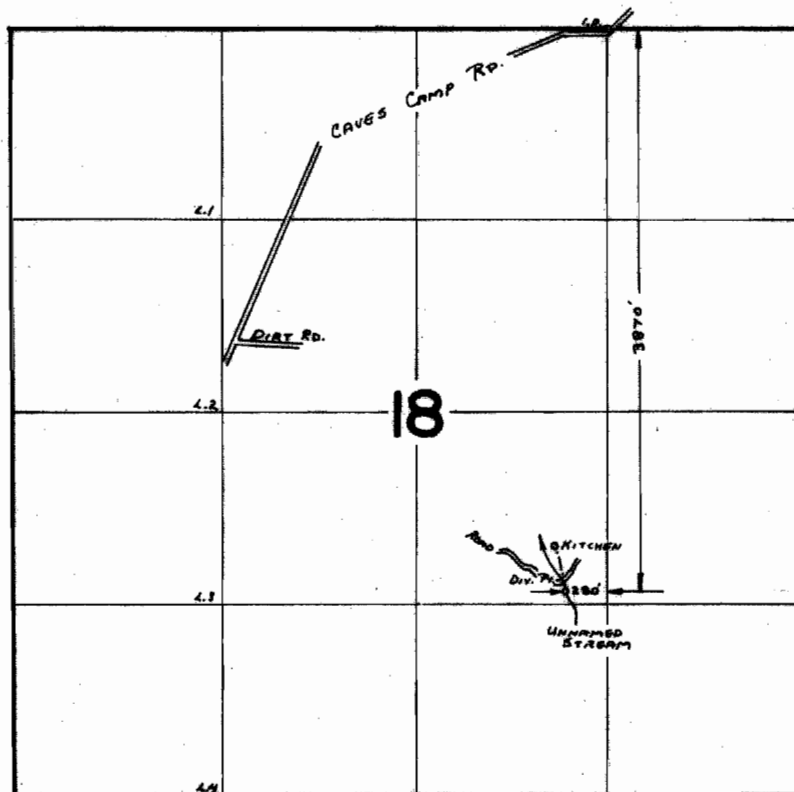

FINAL PROOF SURVEY
UNDER

Application No. 46898 Permit No. 34960
IN NAME OF
SUE LILY (SCHROTH), ALAN FALKOFF
ELYSE WATTENLY, & ROGER LEDBETTER

Surveyed SEPT. 13 1974, by L. Toll