


T.18S., R.5W., W.M.

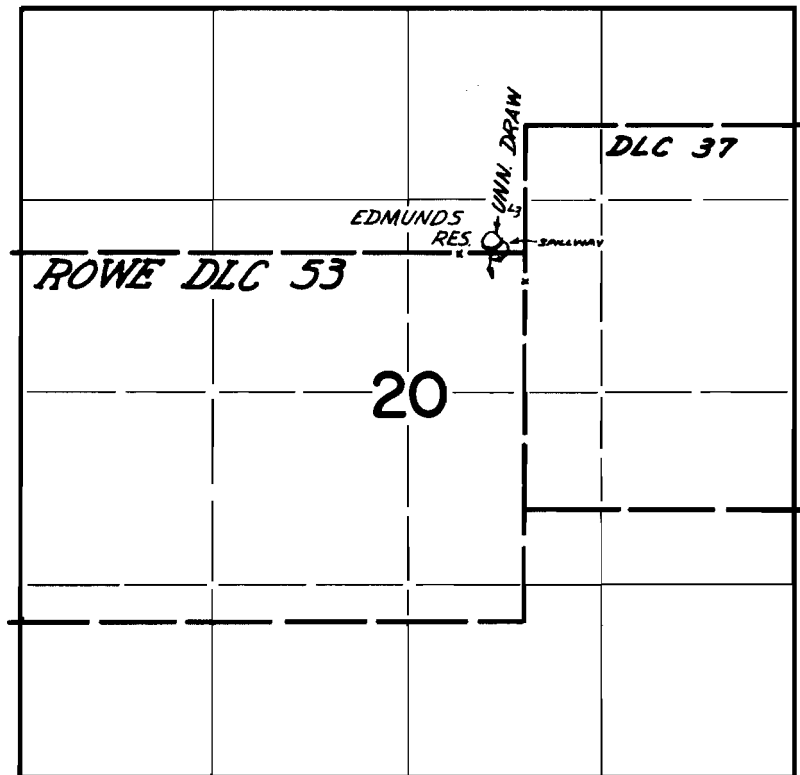

FINAL PROOF SURVEY
UNDER

Application No. R-46828 Permit No. R-5870
IN NAME OF

Coyote Creek Ranch Inc.

Surveyed June 14 1973, by D. Noes