


T.11S.R.8W.W.M.

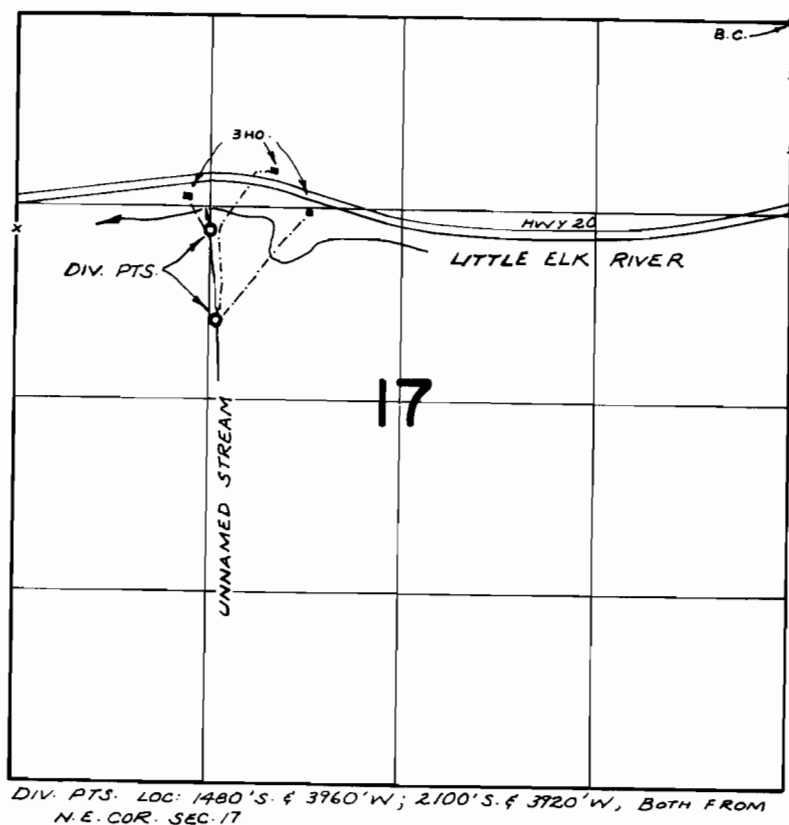

FINAL PROOF SURVEY
UNDER

Application No. 47434 Permit No. 35541
IN NAME OF

DONALD EARL HOPKINS & ORRIE A. & LOIS PAGE

Surveyed AUG. 22, 1974, by R. MUCKEN