





T.11S., R.4W., W.M.

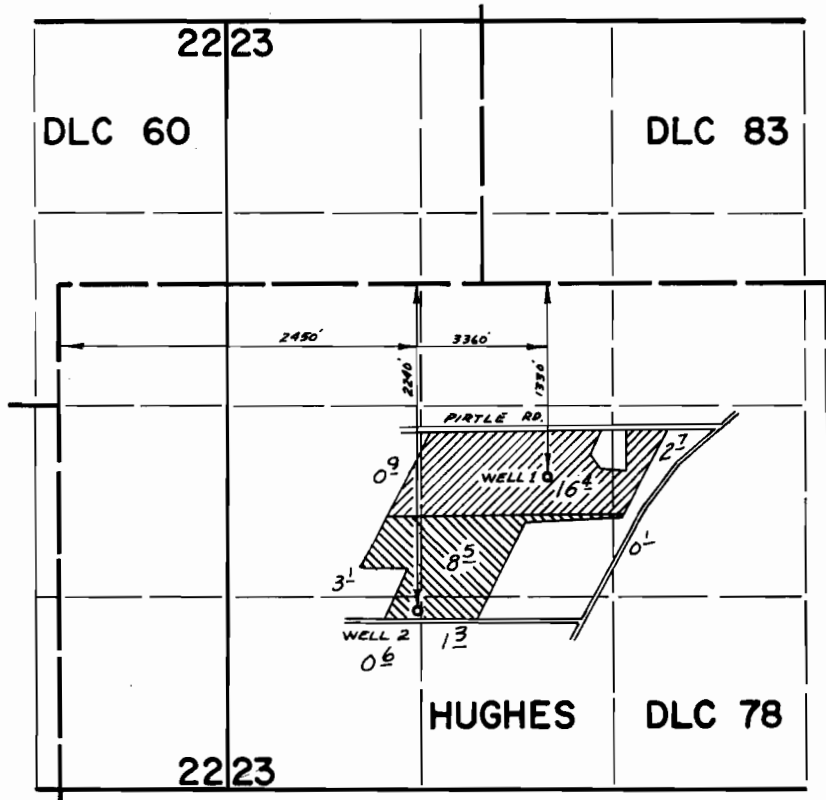

-  PRIMARY UNDER PERMIT G-3839 FROM WELL #1.
-  SUPPLEMENTAL UNDER PERMIT G-5229 FROM WELL #2.
-  PRIMARY UNDER PERMIT G-5229 FROM WELL #2.

FINAL PROOF SURVEY UNDER

Application No. G-4086 Permit No. G-3839
G-5333 Permit No. G-5229
 IN NAME OF

GLORIA I. BOYE

Surveyed April 5 1974, by S.P. Applegate