


T.14S., R.3W., W.M.

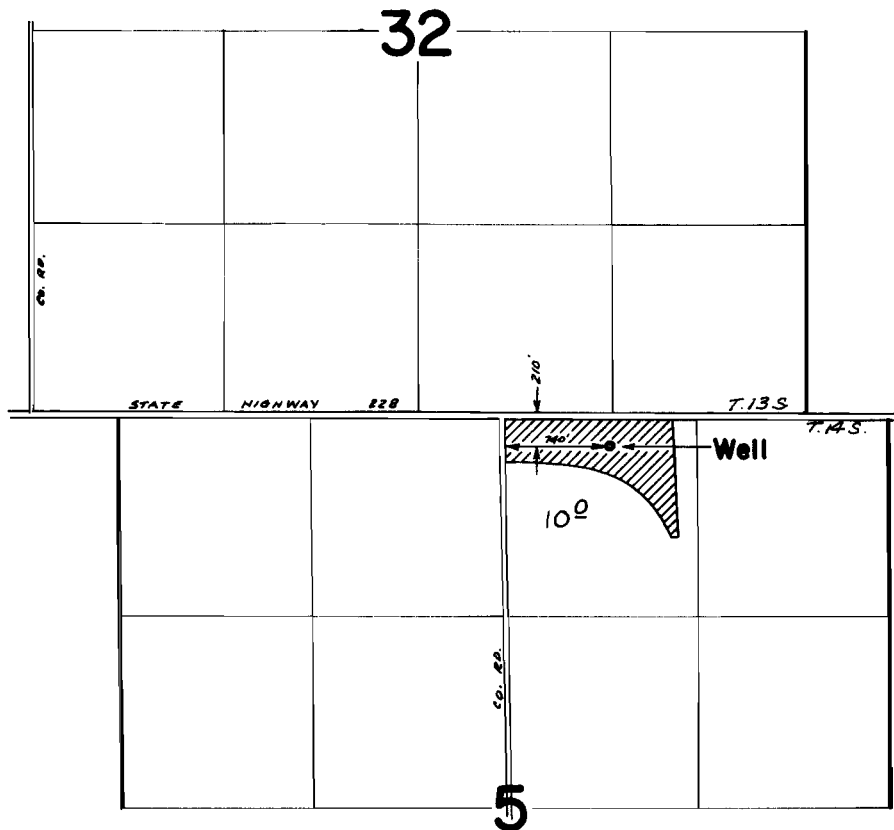

FINAL PROOF SURVEY
UNDER

Application No. G-4190 Permit No. G-3956
IN NAME OF

JAMES H. AND LAURA L. FERRELL

Surveyed Oct. 2, 1973, by D. Norby