


# T. 13 S. R. 1 W. W. M.

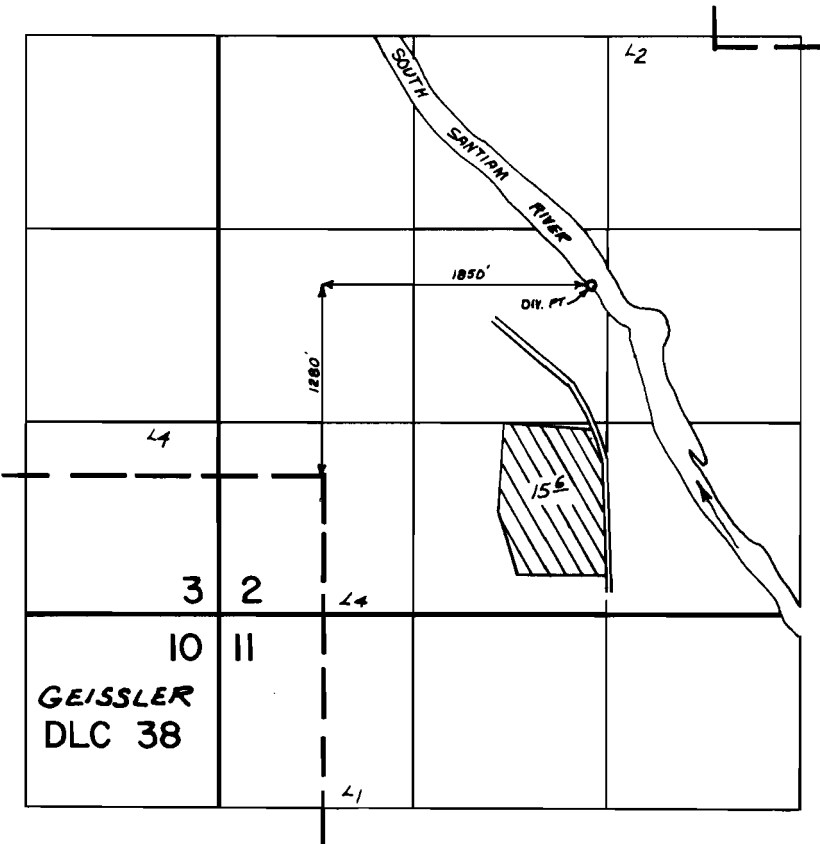

## FINAL PROOF SURVEY UNDER

Application No. 46156 Permit No. 34483  
IN NAME OF

J. G & M. P. CORWIN

Surveyed MAY 9 1973, by R. G. MUCKEN