


T.21S. R.46E. W.M.

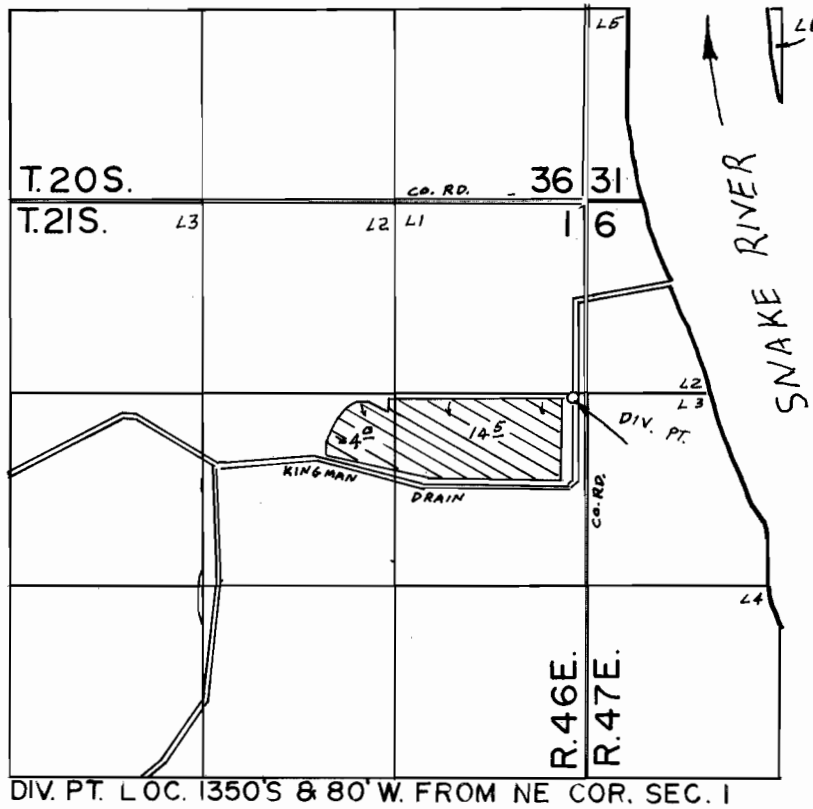

FINAL PROOF SURVEY
UNDER

Application No. 42896 Permit No. 32878
IN NAME OF

EARL CAMPBELL

Surveyed JUN 24 1974, by LH NUNN