


T.5S. R.1W. W.M.

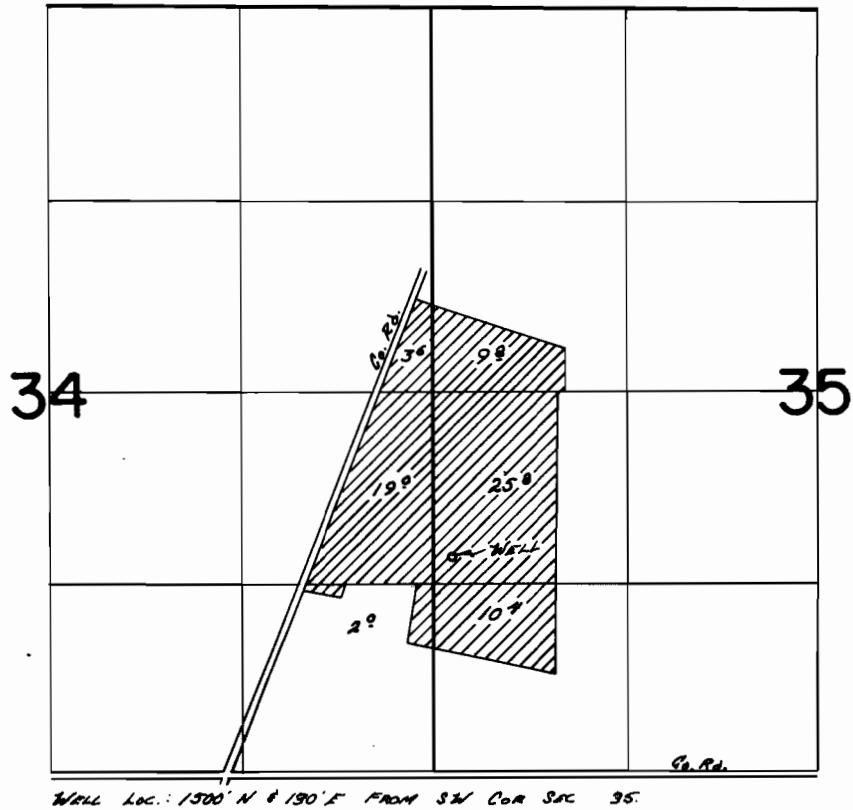

FINAL PROOF SURVEY UNDER

Application No. G-3979 Permit No. G-3790
IN NAME OF

JOE BOCHSLER

Surveyed May 21 1979, by T. J. Paul