


T.5S. R.1W. W.M.

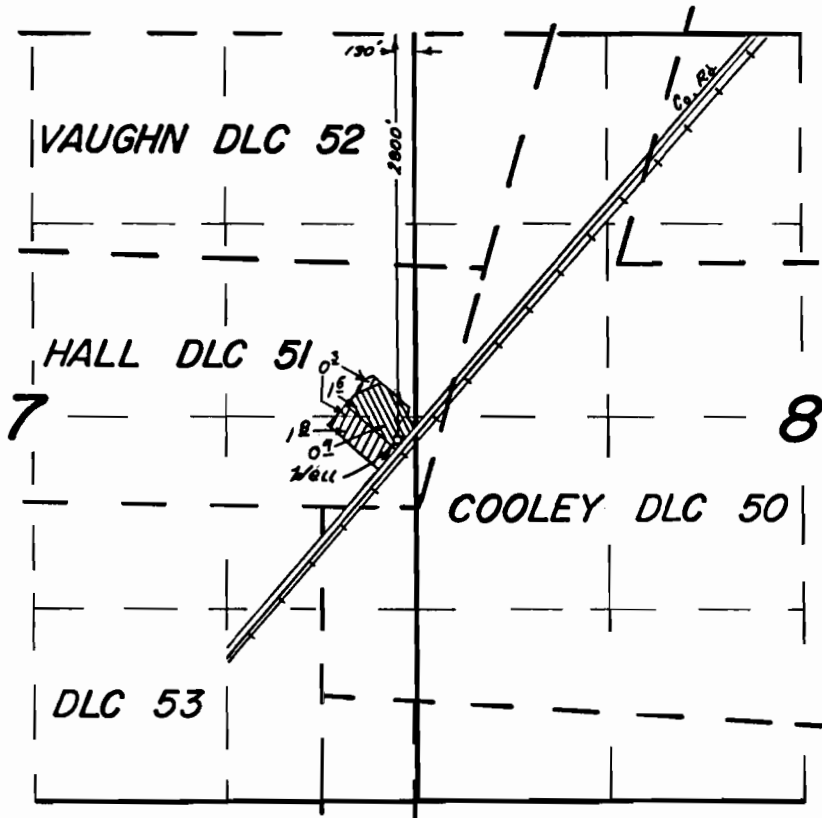

FINAL PROOF SURVEY UNDER

Application No. G-7480 Permit No. G-6962
G-4052 G-3799
IN NAME OF



ST. LUKE'S CEMETERY ASSOC., INC.

Surveyed May 18 1979, by T. J. Paul
JUNE 8 1979 L. H. NUNN