


T. 9 S., R. 1 E., W. M.

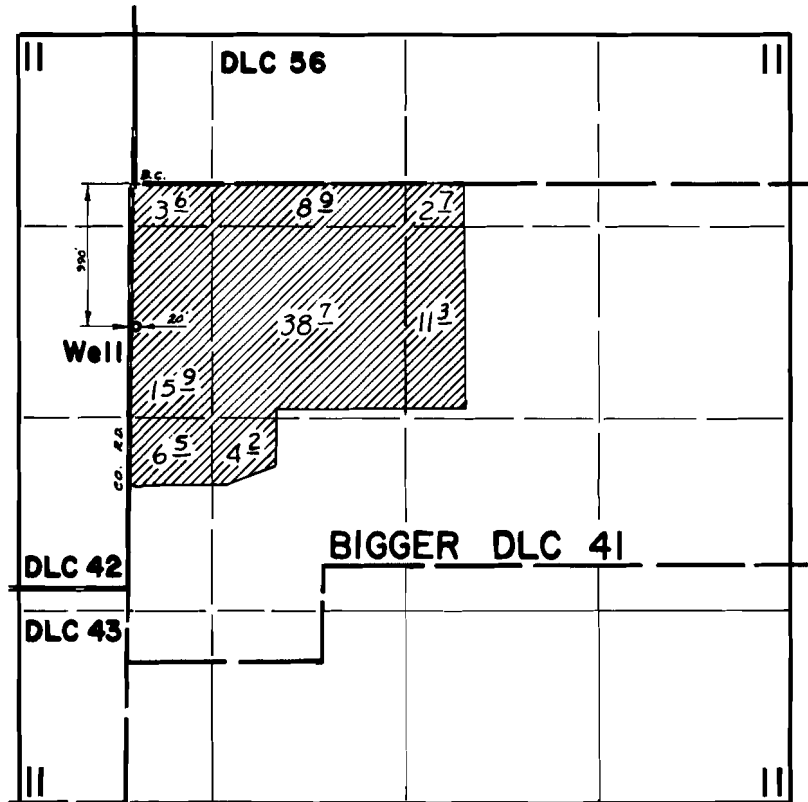

FINAL PROOF SURVEY UNDER

Application No. G-4292 Permit No. G-4040
IN NAME OF

NIELSON-HARTMANN

Surveyed July 3, 1973, by D. Norby