


T.5S. R.2W. W.M.

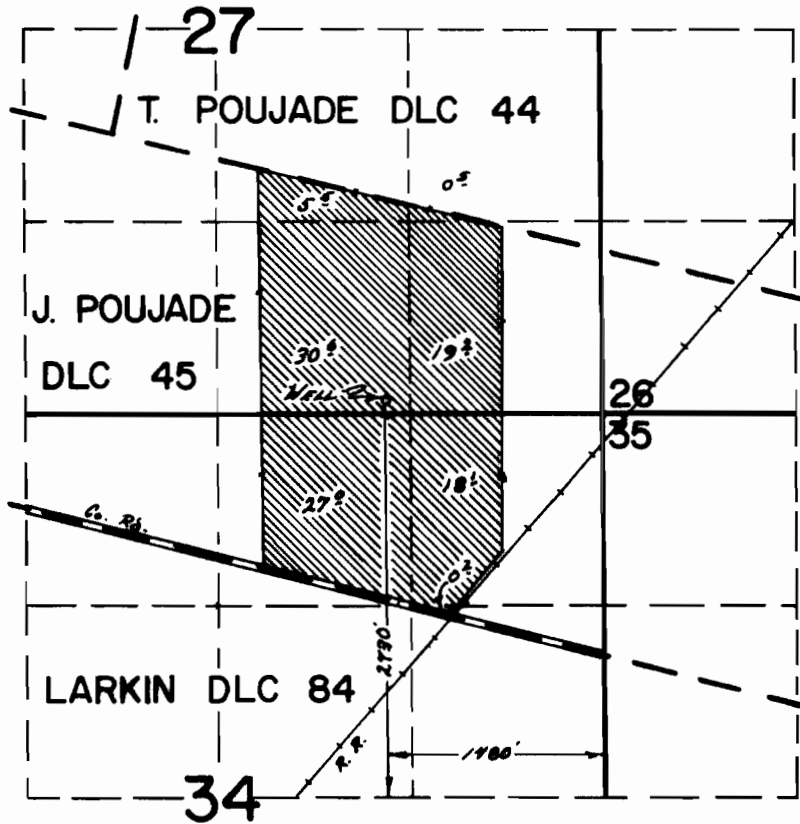

**FINAL PROOF SURVEY**  
UNDER

Application No. G-4933 Permit No. G-4657  
IN NAME OF

WILLIAM ALBRIGHT

Surveyed May 22 1973, by T. J. Paul