


T.4 S.R. I.W. W.M

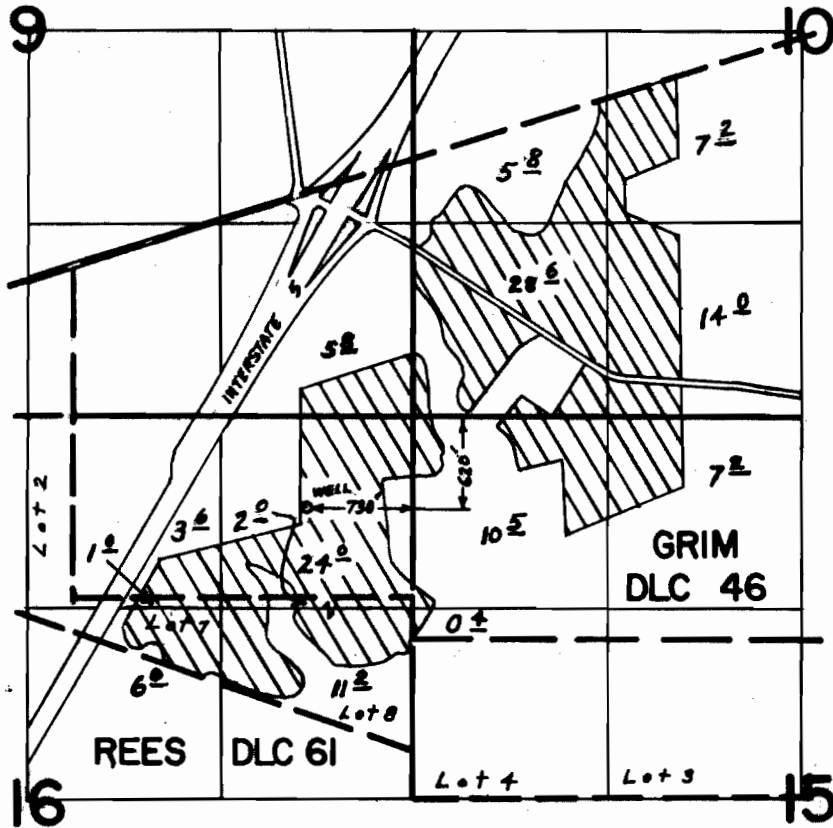

FINAL PROOF SURVEY UNDER

Application No. G-1992 Permit No. G-4710
IN NAME OF

KRAUS BROS.

Surveyed AUG 16 1973 by L. E. GOULD