


T.5&6S. R.1W. W.M.

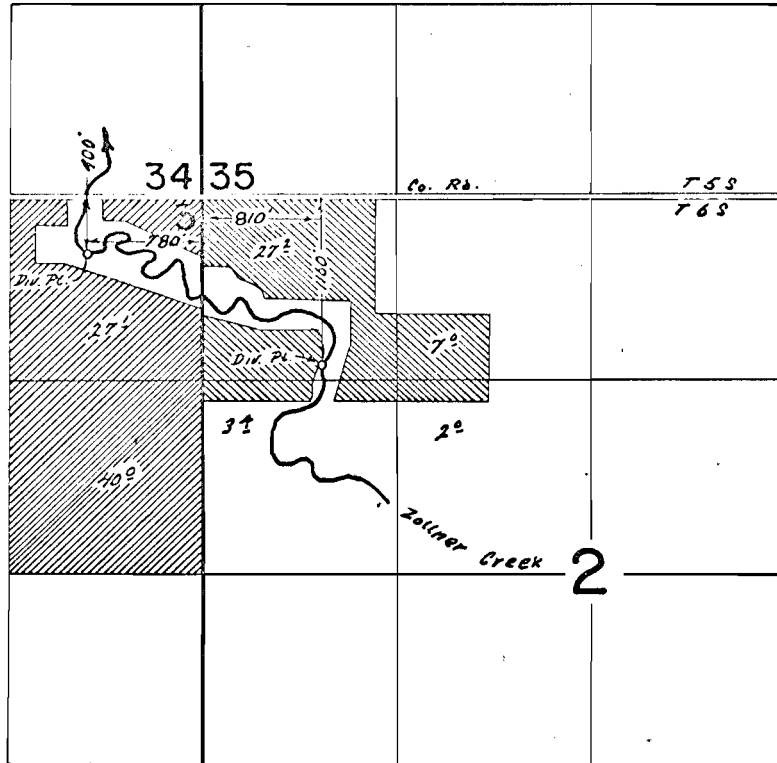

FINAL PROOF SURVEY UNDER

Application No. 40719 Permit No. 30332
44974 33617
 IN NAME OF



HAROLD KRAEMER

Surveyed May 21 1973, by T.V. PAUL