


T.4S. R.1W. W.M.

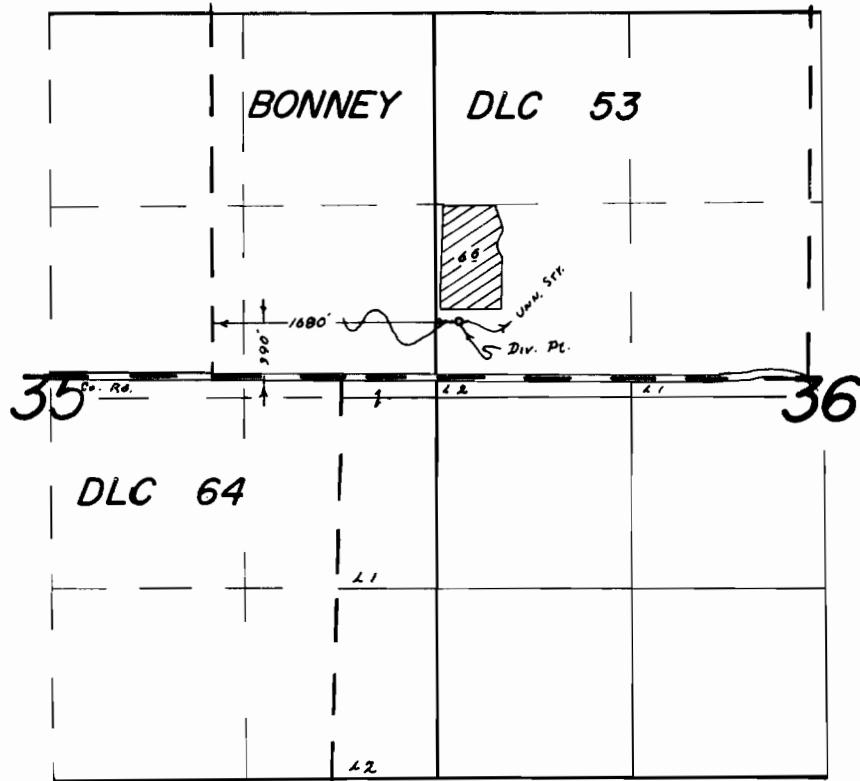

**FINAL PROOF SURVEY**  
UNDER

transfer No. S 209  
Application No. 42802 Permit No. 33790  
IN NAME OF

WM. N. STRUBHAR

Surveyed JUNE 5 1973, by R. G. MUCKEN  
Sept. 6, 1977, by B. R. SUND