


T. 7 S. R. 1 E. W. M.

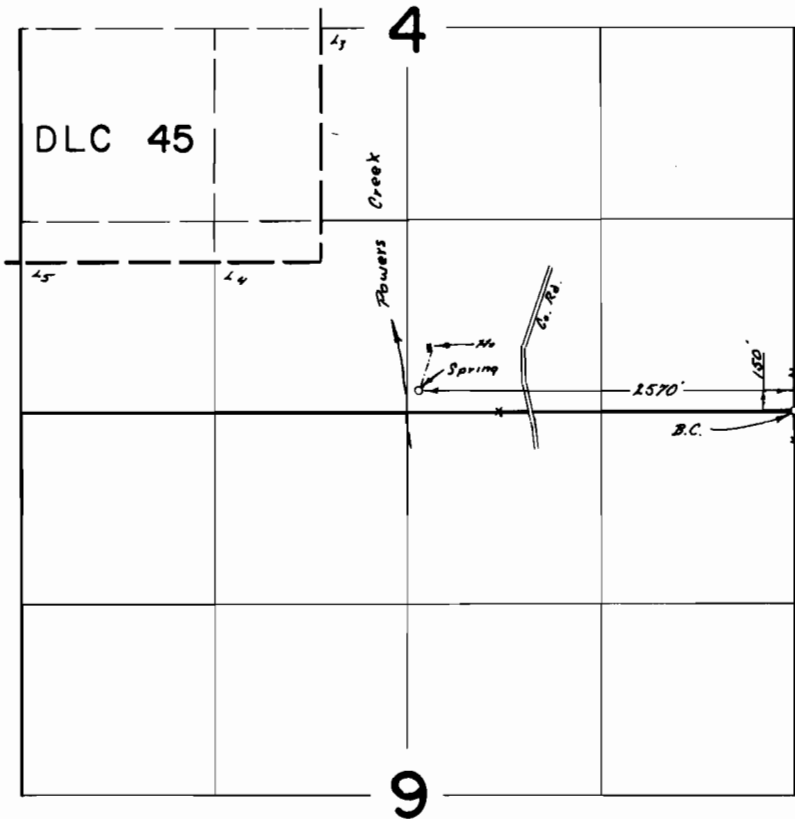

FINAL PROOF SURVEY
UNDER

Application No. 46150 Permit No. 34479
IN NAME OF

RUSSELL POTTS

Surveyed Oct 4 1973, by R.B. Mucken