


T.8S.R.IW.W.M.

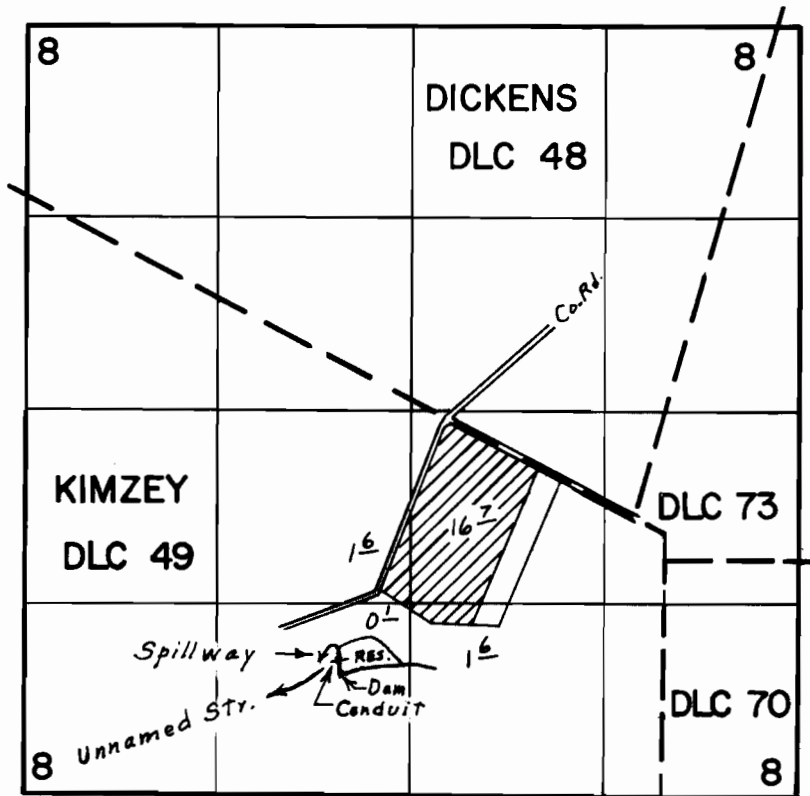

Div. Pt. located 850' S. & 2230' W. from N.E. Cor. Kimzey DLC 49

FINAL PROOF SURVEY UNDER

R-45206 R-5333
 Application No. 45237 Permit No. 33784

IN NAME OF

ESTATE OF CLARENCE GOFFIN

Surveyed JULY 5 1973, by L.E. GOULD