


T.8S.R.1W.W.M.

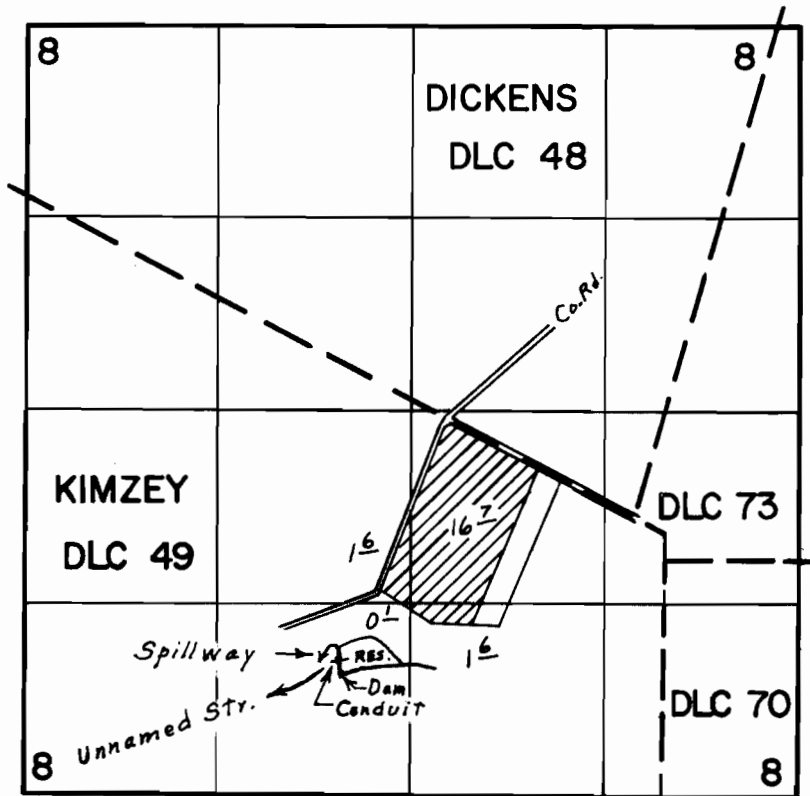

Div. Pt. located 850' S. & 2230' W. from N.E. Cor. Kimzey DLC 49

FINAL PROOF SURVEY UNDER

R-45206 R-5333
Application No. 45237 Permit No. 33784

IN NAME OF

ESTATE OF CLARENCE GOFFIN

Surveyed JULY 5 19 73, by L.E. GOULD