


BOARDMAN SAFETY REST AREA
COLUMBIA RIVER HIGHWAY
MORROW COUNTY

6-2946

6-9180

No.

No.

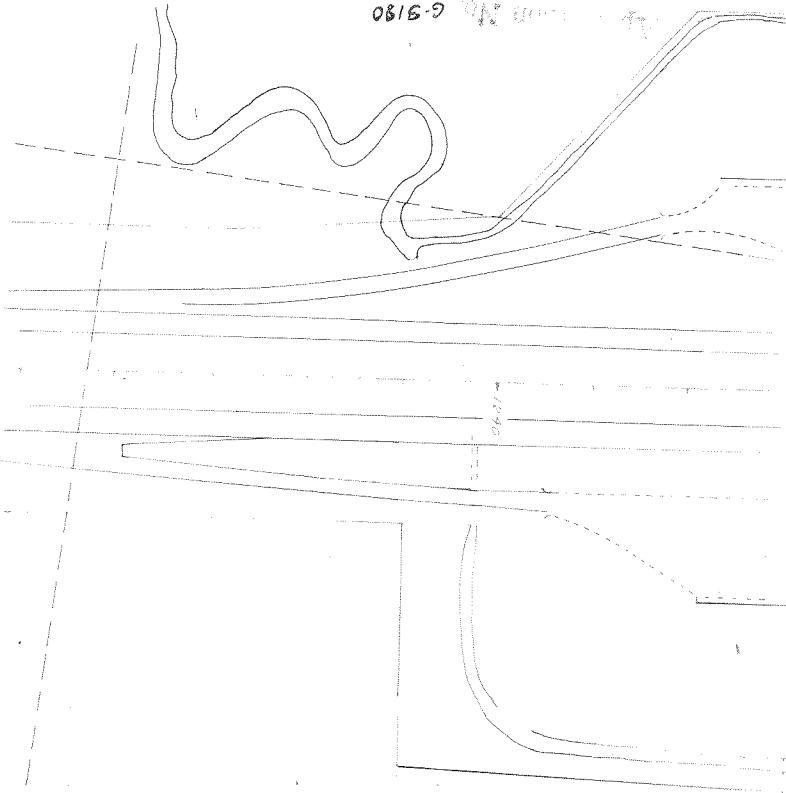

0-6

PARKING

WATER FOR PUBLIC USE

ARTESIAN WELL LOCATION

270'

380'

N 1/4 SEC. 13

T 4 N, R 24 E

