


G-4060

42327

T. 1 S., R. 23 E., W. M.

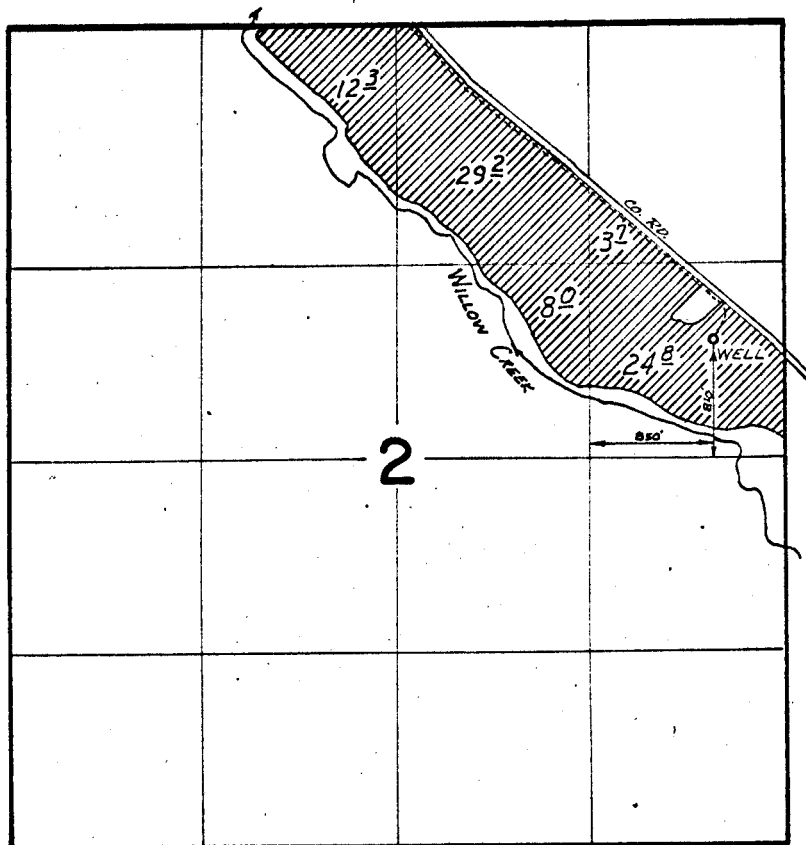

**FINAL PROOF SURVEY**  
UNDER

Application No. G-4298 Permit No. G-4060  
IN NAME OF

HAROLD C. SHERER

Surveyed MAY 10 1974, by D. Nozby