G - 4353
423249

T.2N., R.25E., W.M.

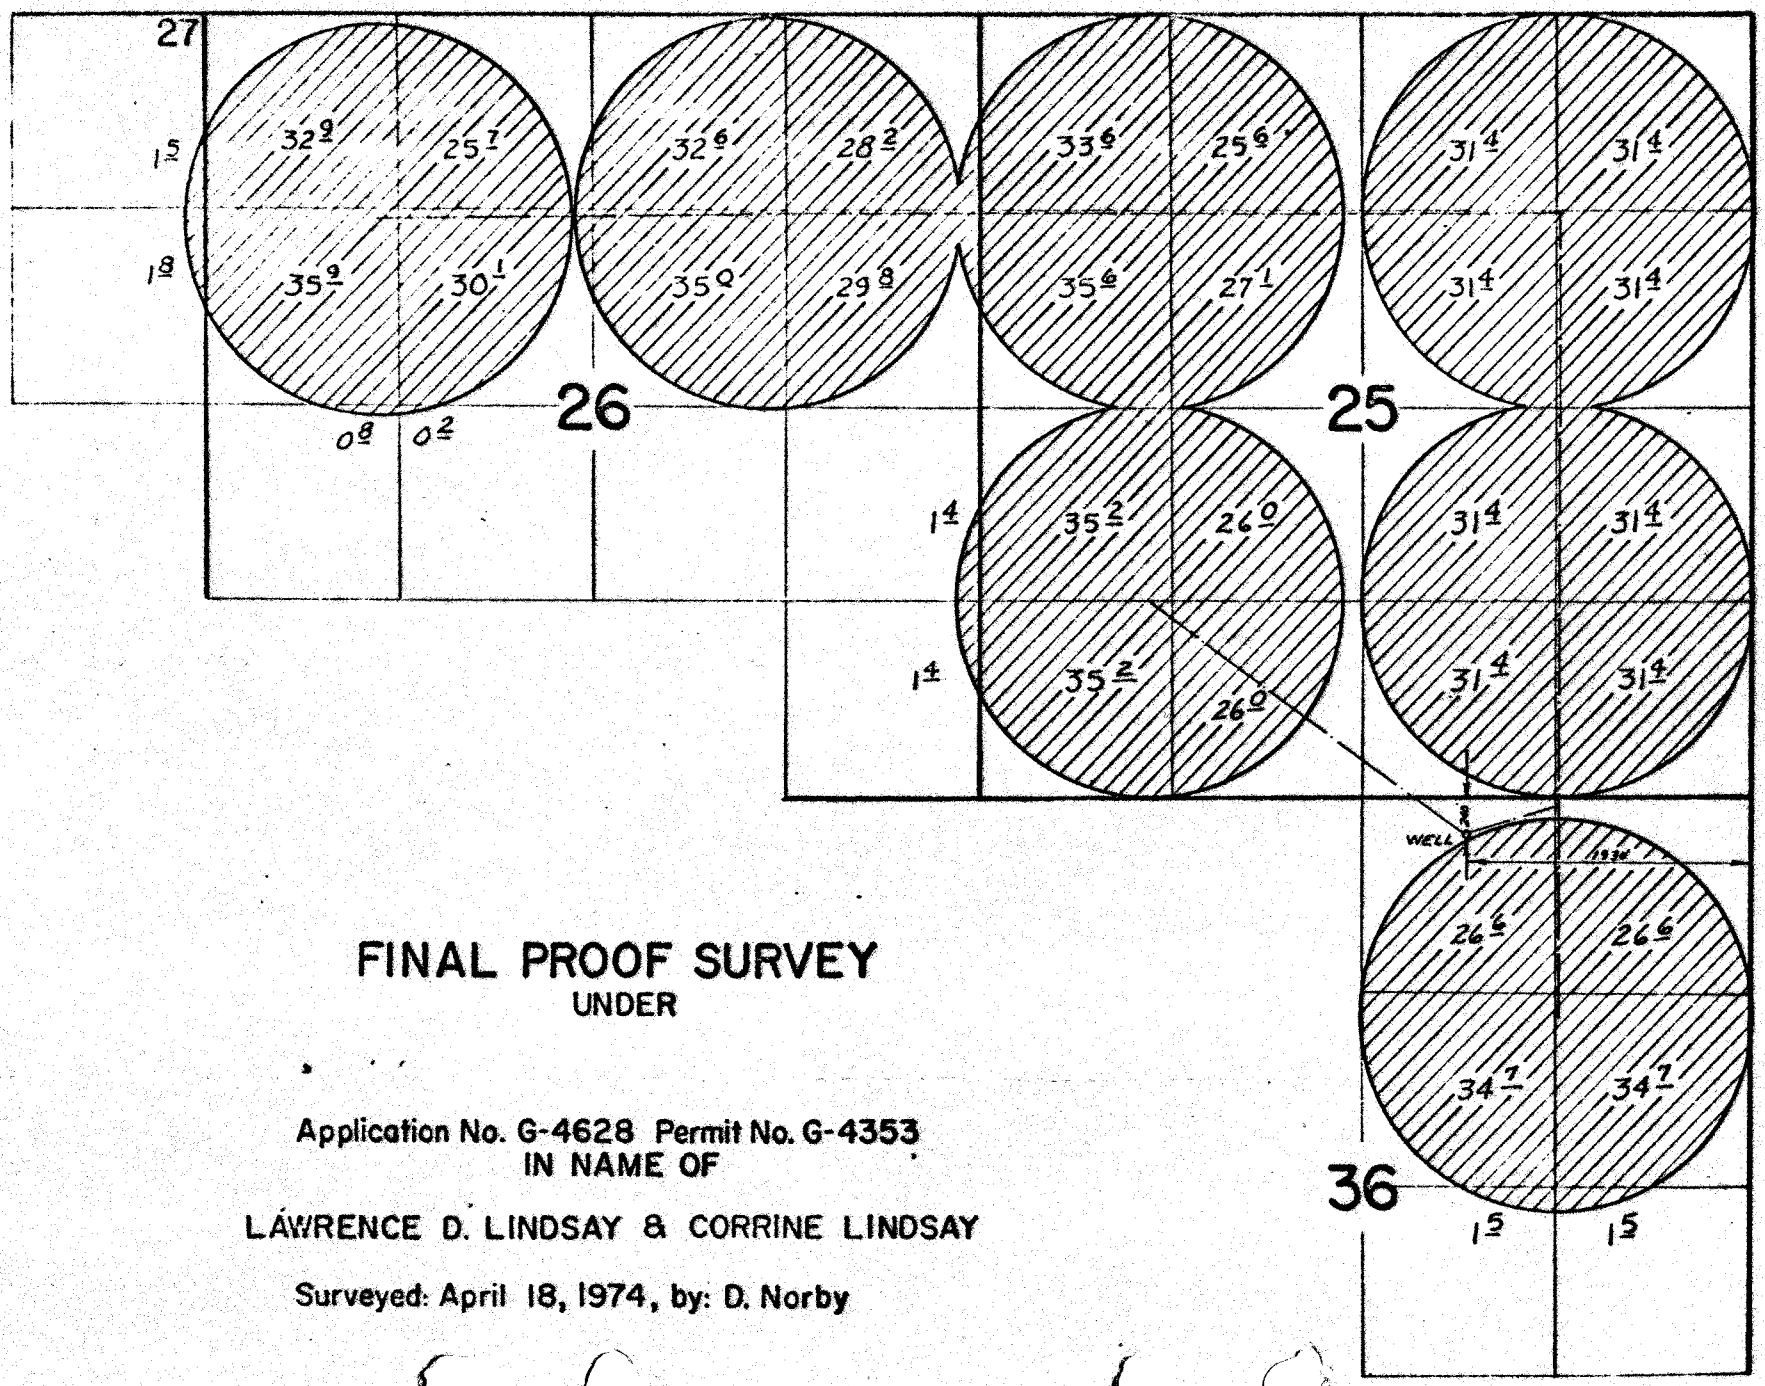

FINAL PROOF SURVEY
UNDER

Application No. G-4628 Permit No. G-4353
IN NAME OF

LAWRENCE D. LINDSAY & CORRINE LINDSAY

Surveyed: April 18, 1974, by: D. Norby

41049 172-21