Permit Map File G-4354
42330

T.18&2N. R.26&27E. W.M.

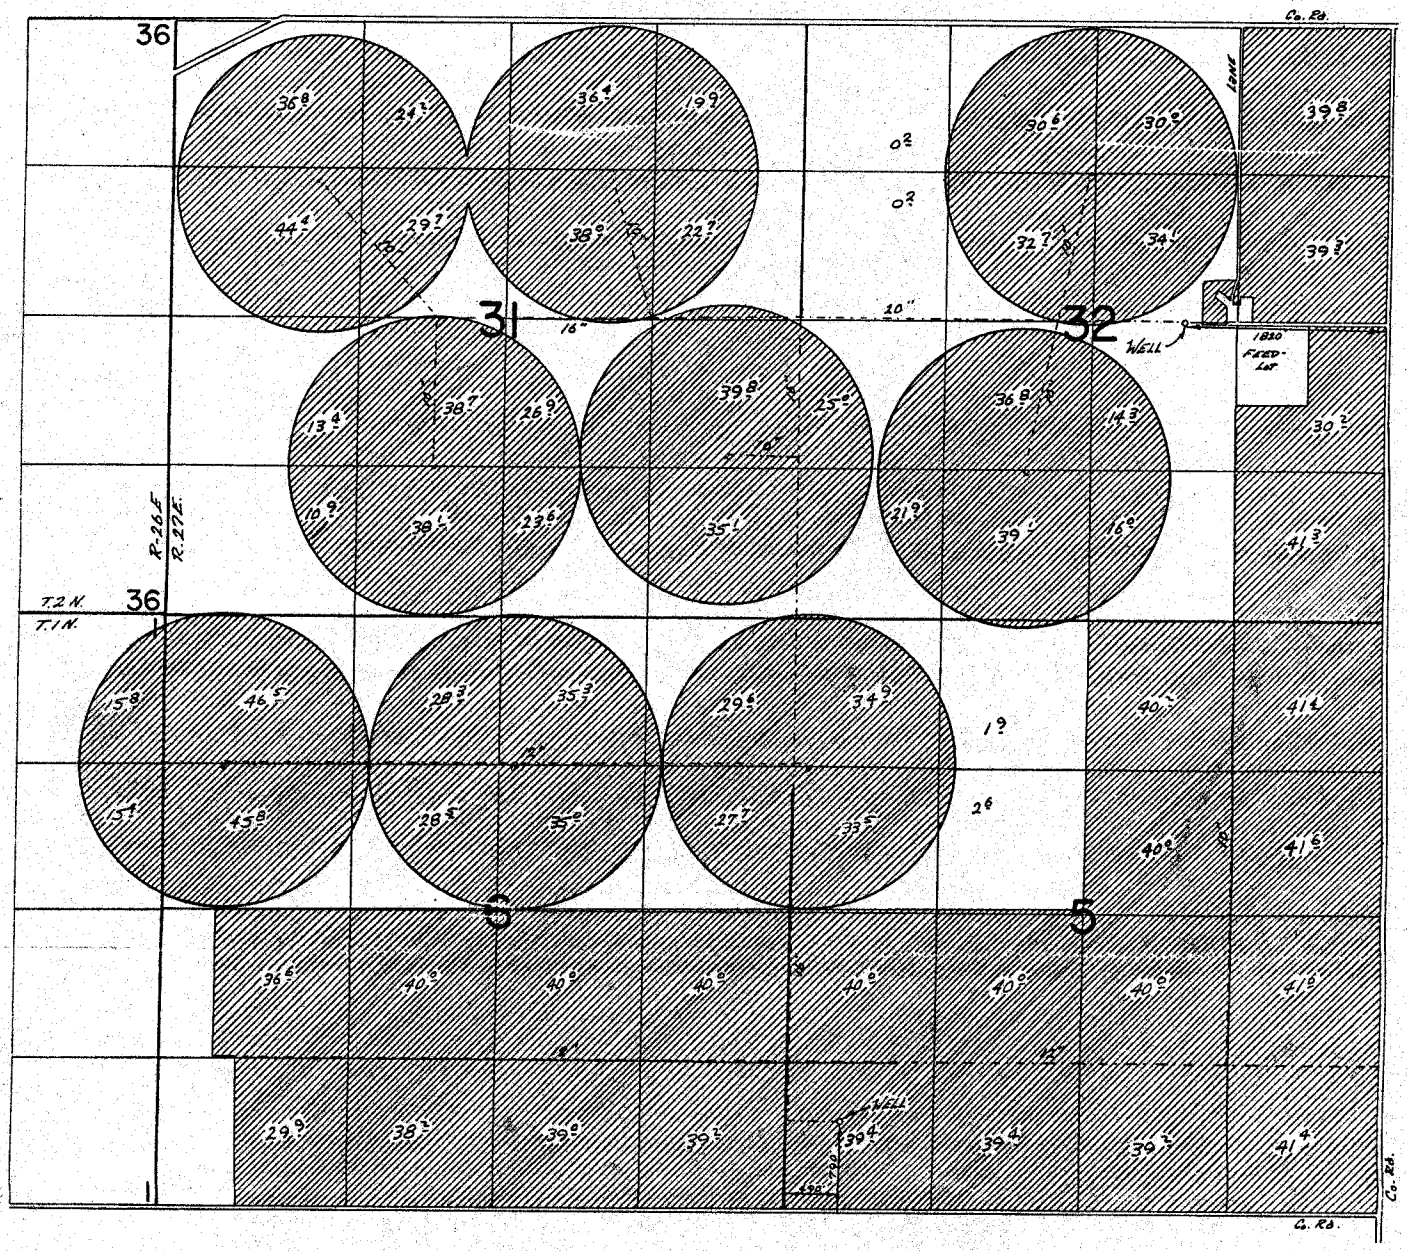

FINAL PROOF SURVEY
UNDER

See Logger map file

Application No. G-4629 Permit No. G-4354
IN NAME OF

CAMPBELL RANCH INC.

Surveyed April 18 1974, by T. J. PAUL

172-29, 272-28E, 1974 F