G-4768
42331

T.2S., R.25E., W.M.

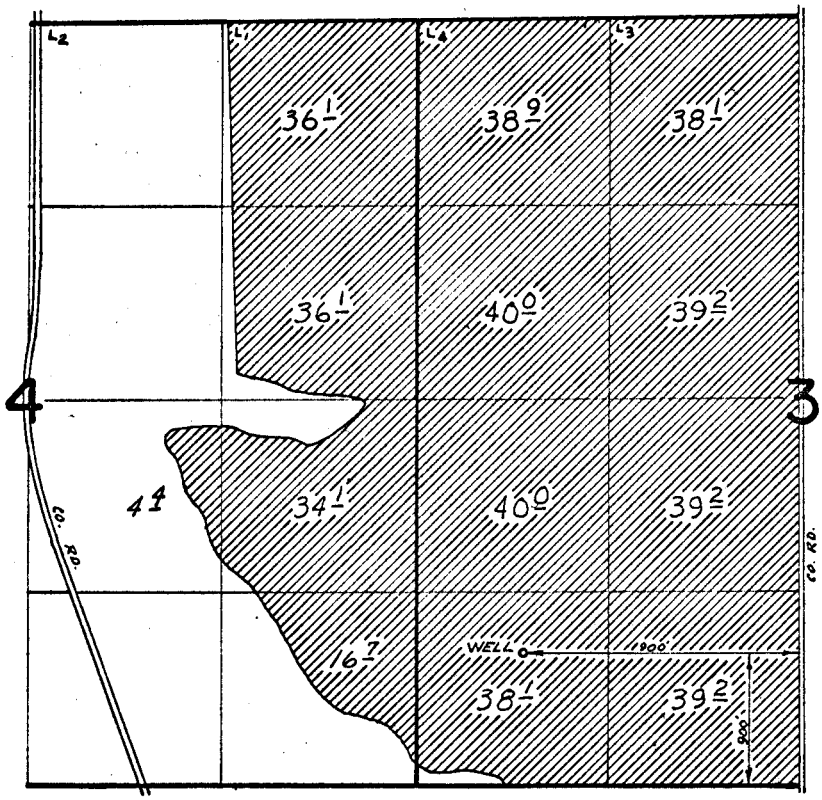

FINAL PROOF SURVEY
UNDER

Application No. G-5058 Permit No. G-4768
IN NAME OF

CLINTON KENNETH & LUCILE PECK

Surveyed MAY 10 1974, by D. NORBY

41049-372-234