


T.9S. R.5W. W.M.

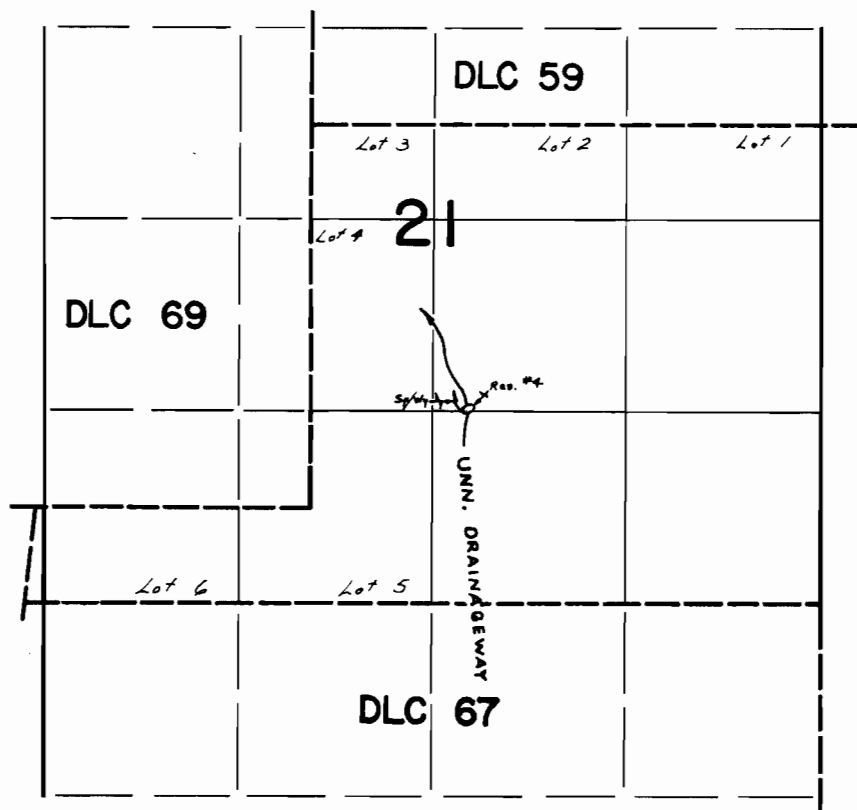

FINAL PROOF SURVEY
UNDER

Application No. R-46819 Permit No. R-5615
IN NAME OF

ALVA MITCHELL

Surveyed MARCH 16, 1973, by R. MUCKEN