


T.9S. R.5W. W.M.

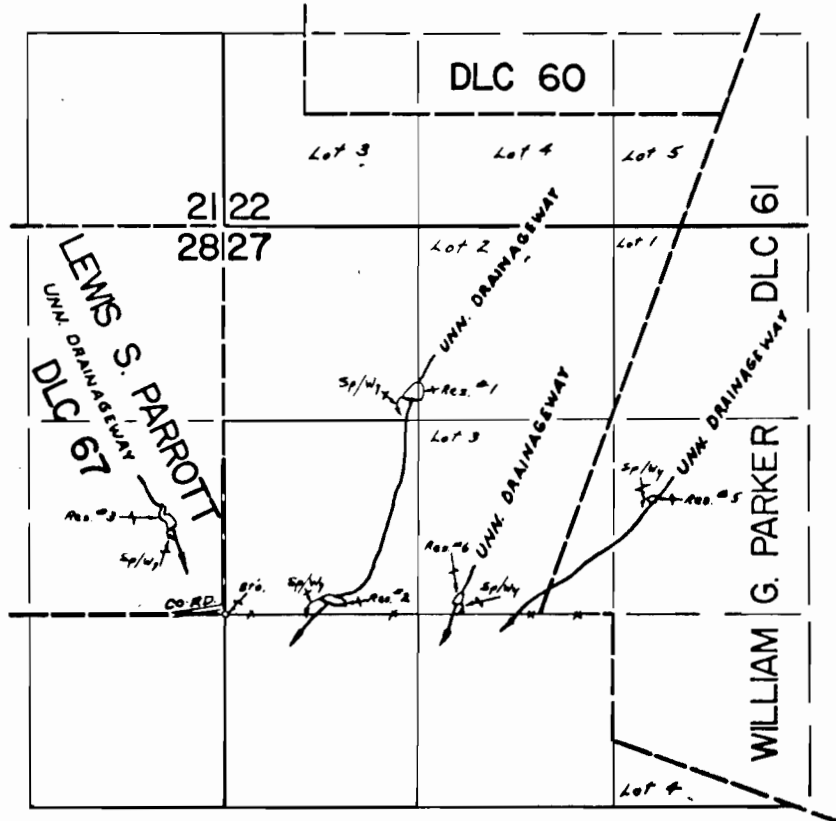

FINAL PROOF SURVEY
UNDER

R-46817 R-5613
R-46818 R-5614
Application No. R-46820 Permit No. R-5637
IN NAME OF

ALVA MITCHELL

Surveyed MARCH 16, 1973, by R. MUCKEN