


G 1690

42337

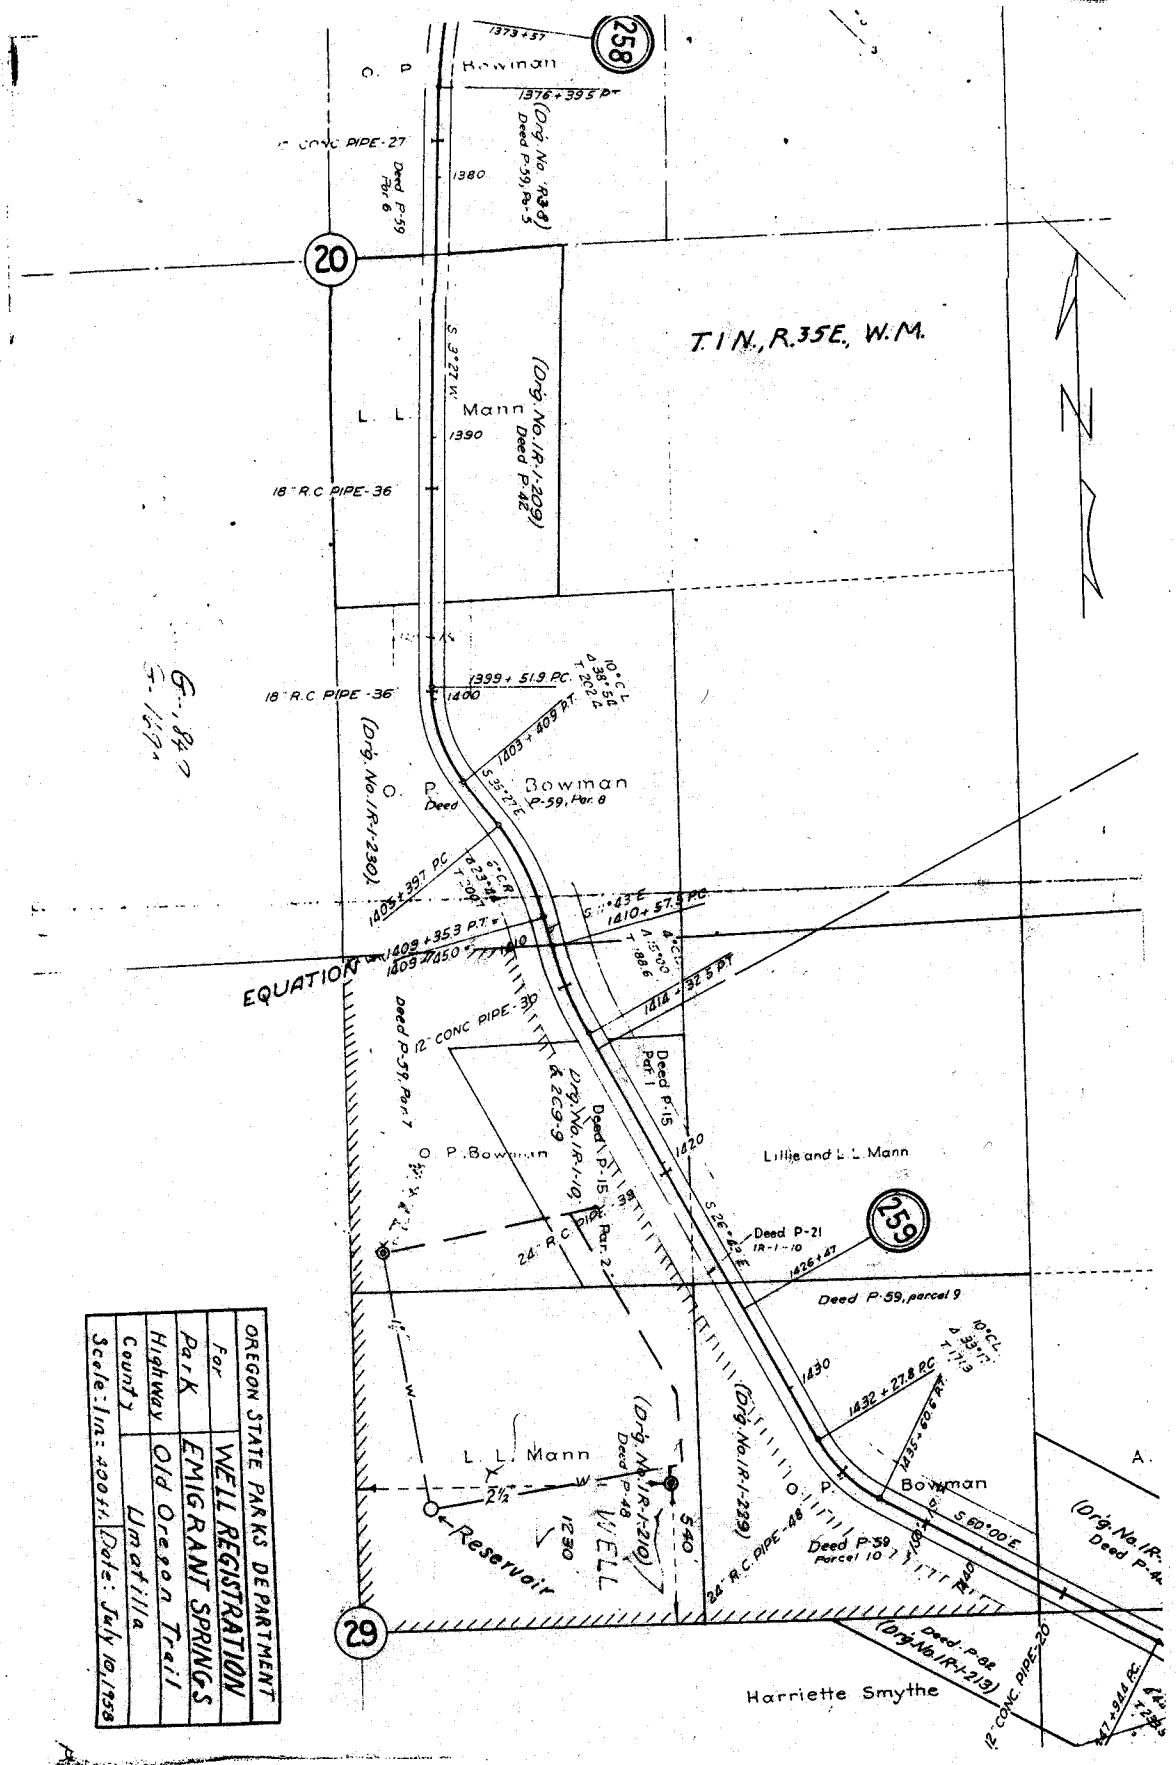

G-1847
5-1594

EQUATION

OREGON STATE PARKS DEPARTMENT	
For	WELL REGISTRATION
Park	EMIGRANT SPRINGS
Highway	Old Oregon Trail
Scale: 1 in. = 400 ft. Date: July 10, 1938	