


G-1952  
42338

# T.2S.,R.31E.,W.M.

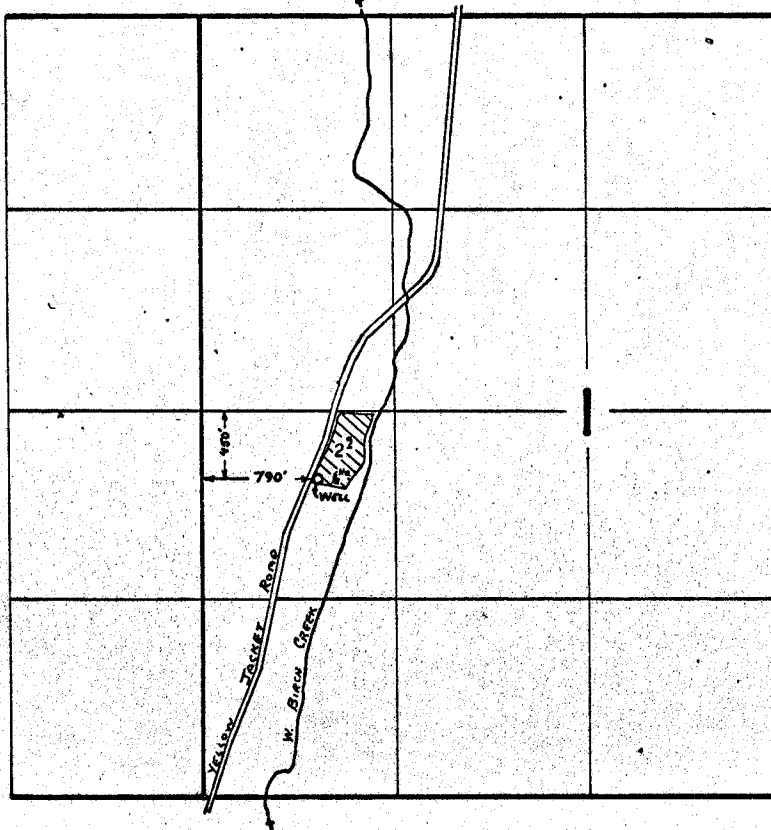

## FINAL PROOF SURVEY UNDER

Application No. G-2118... Permit No. G-1952...  
IN NAME OF

.....ARTHUR HUTCHISON.....

Surveyed Aug. 7, 1974, by L. T. Tolh.....