


G-4067  
42339

T.4N., R.28E., W.M.

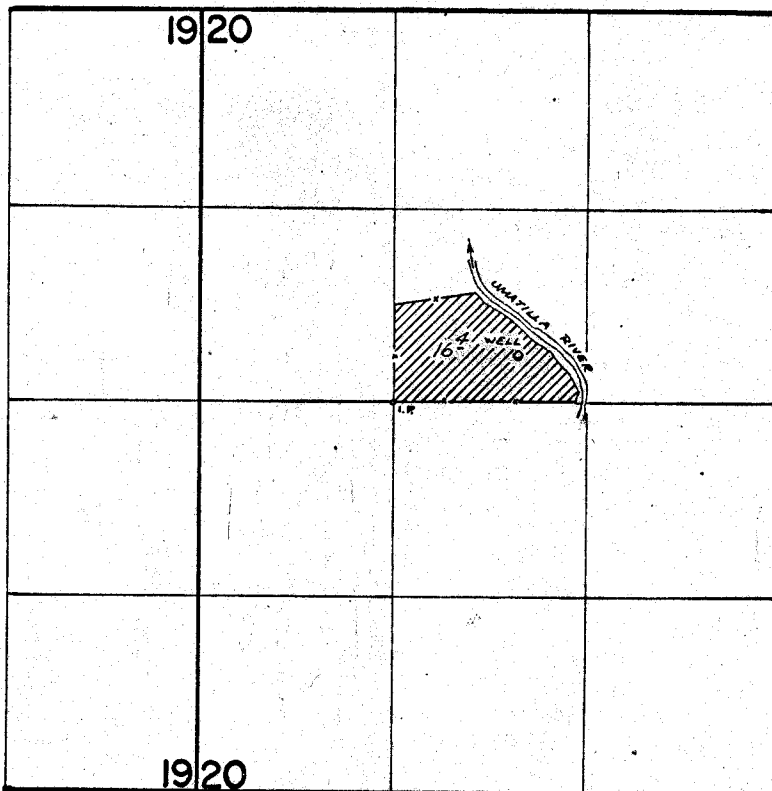

WELL LOCATED: 310' N & 850' E FROM SW COR. SE 1/4 NW 1/4 SEC 20.

**FINAL PROOF SURVEY**  
UNDER

Application No. G-4306 Permit No. G-4067  
IN NAME OF

ESTATE OF TOM QUICK

Surveyed April 10 1974, by D. Dorby